



AS CONSTRUCTED

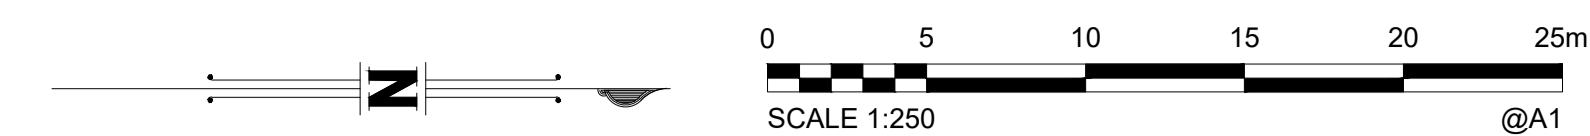

REGISTERED SURVEYOR'S CERTIFICATION
 I, Gordon Nicholson, hereby certify that the vertical and horizontal locations and dimensions shown on this plan are a true and correct record and were located by survey.
 Registered Surveyor (sig) Reg Surveyor No. SA 3405 Date: 24/10/2022

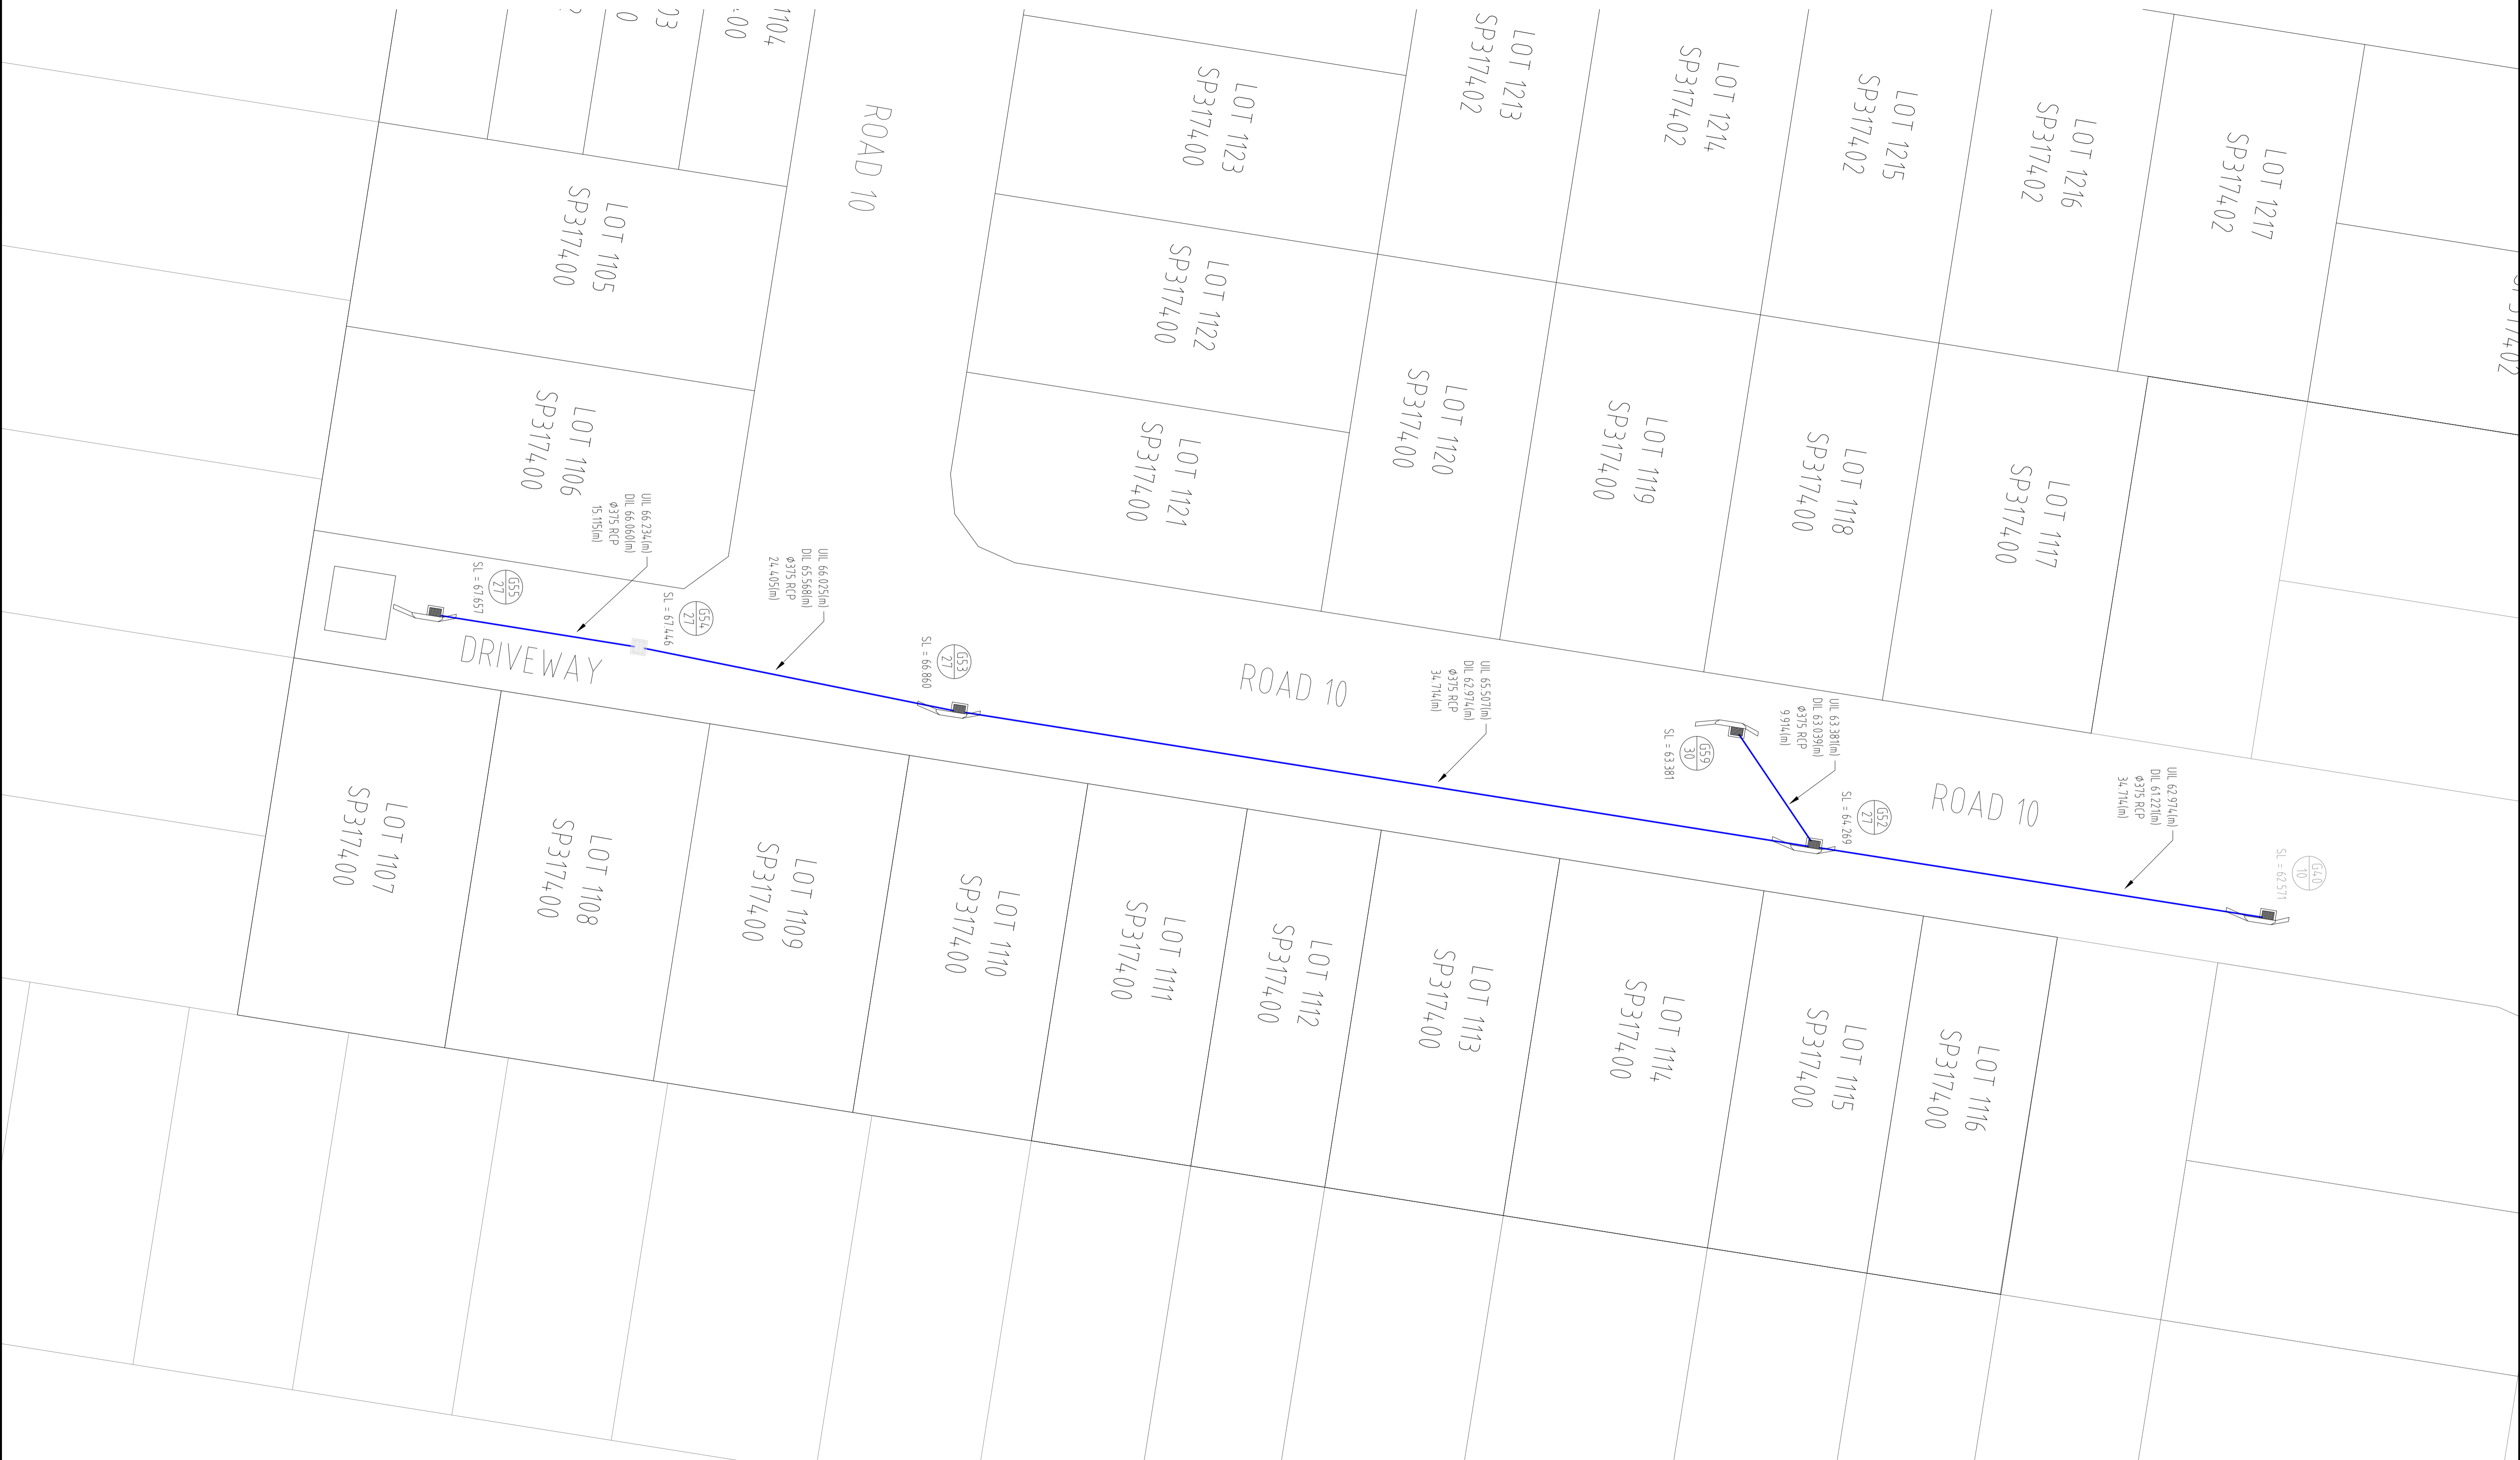

A1	INDEX	DATE	AS CONSTRUCTED	MW	DAM	PASSED	DRAWN	CHECKED	PASSED	INITIALS	DATE		Ipswich City Council 8509/2021/PDA AS CONSTRUCTED SURVEY - STORMWATER RIPLEY VALLEY, STAGE 11 QLD	SHEET 1 OF 1 SHEETS	SCALE 1:250
														REVISION DATE 24/10/2022	REVISION A
															DISCIPLINE CODE -