


AS CONSTRUCTED



REGISTERED SURVEYOR'S CERTIFICATION
 I, Gordon Nicholson, hereby certify that the vertical and horizontal locations and dimensions shown on this plan are a true and correct record and were located by survey.
 Registered Surveyor (sig) Reg. Surveyor No. SA 3405 Date: 24/10/2022

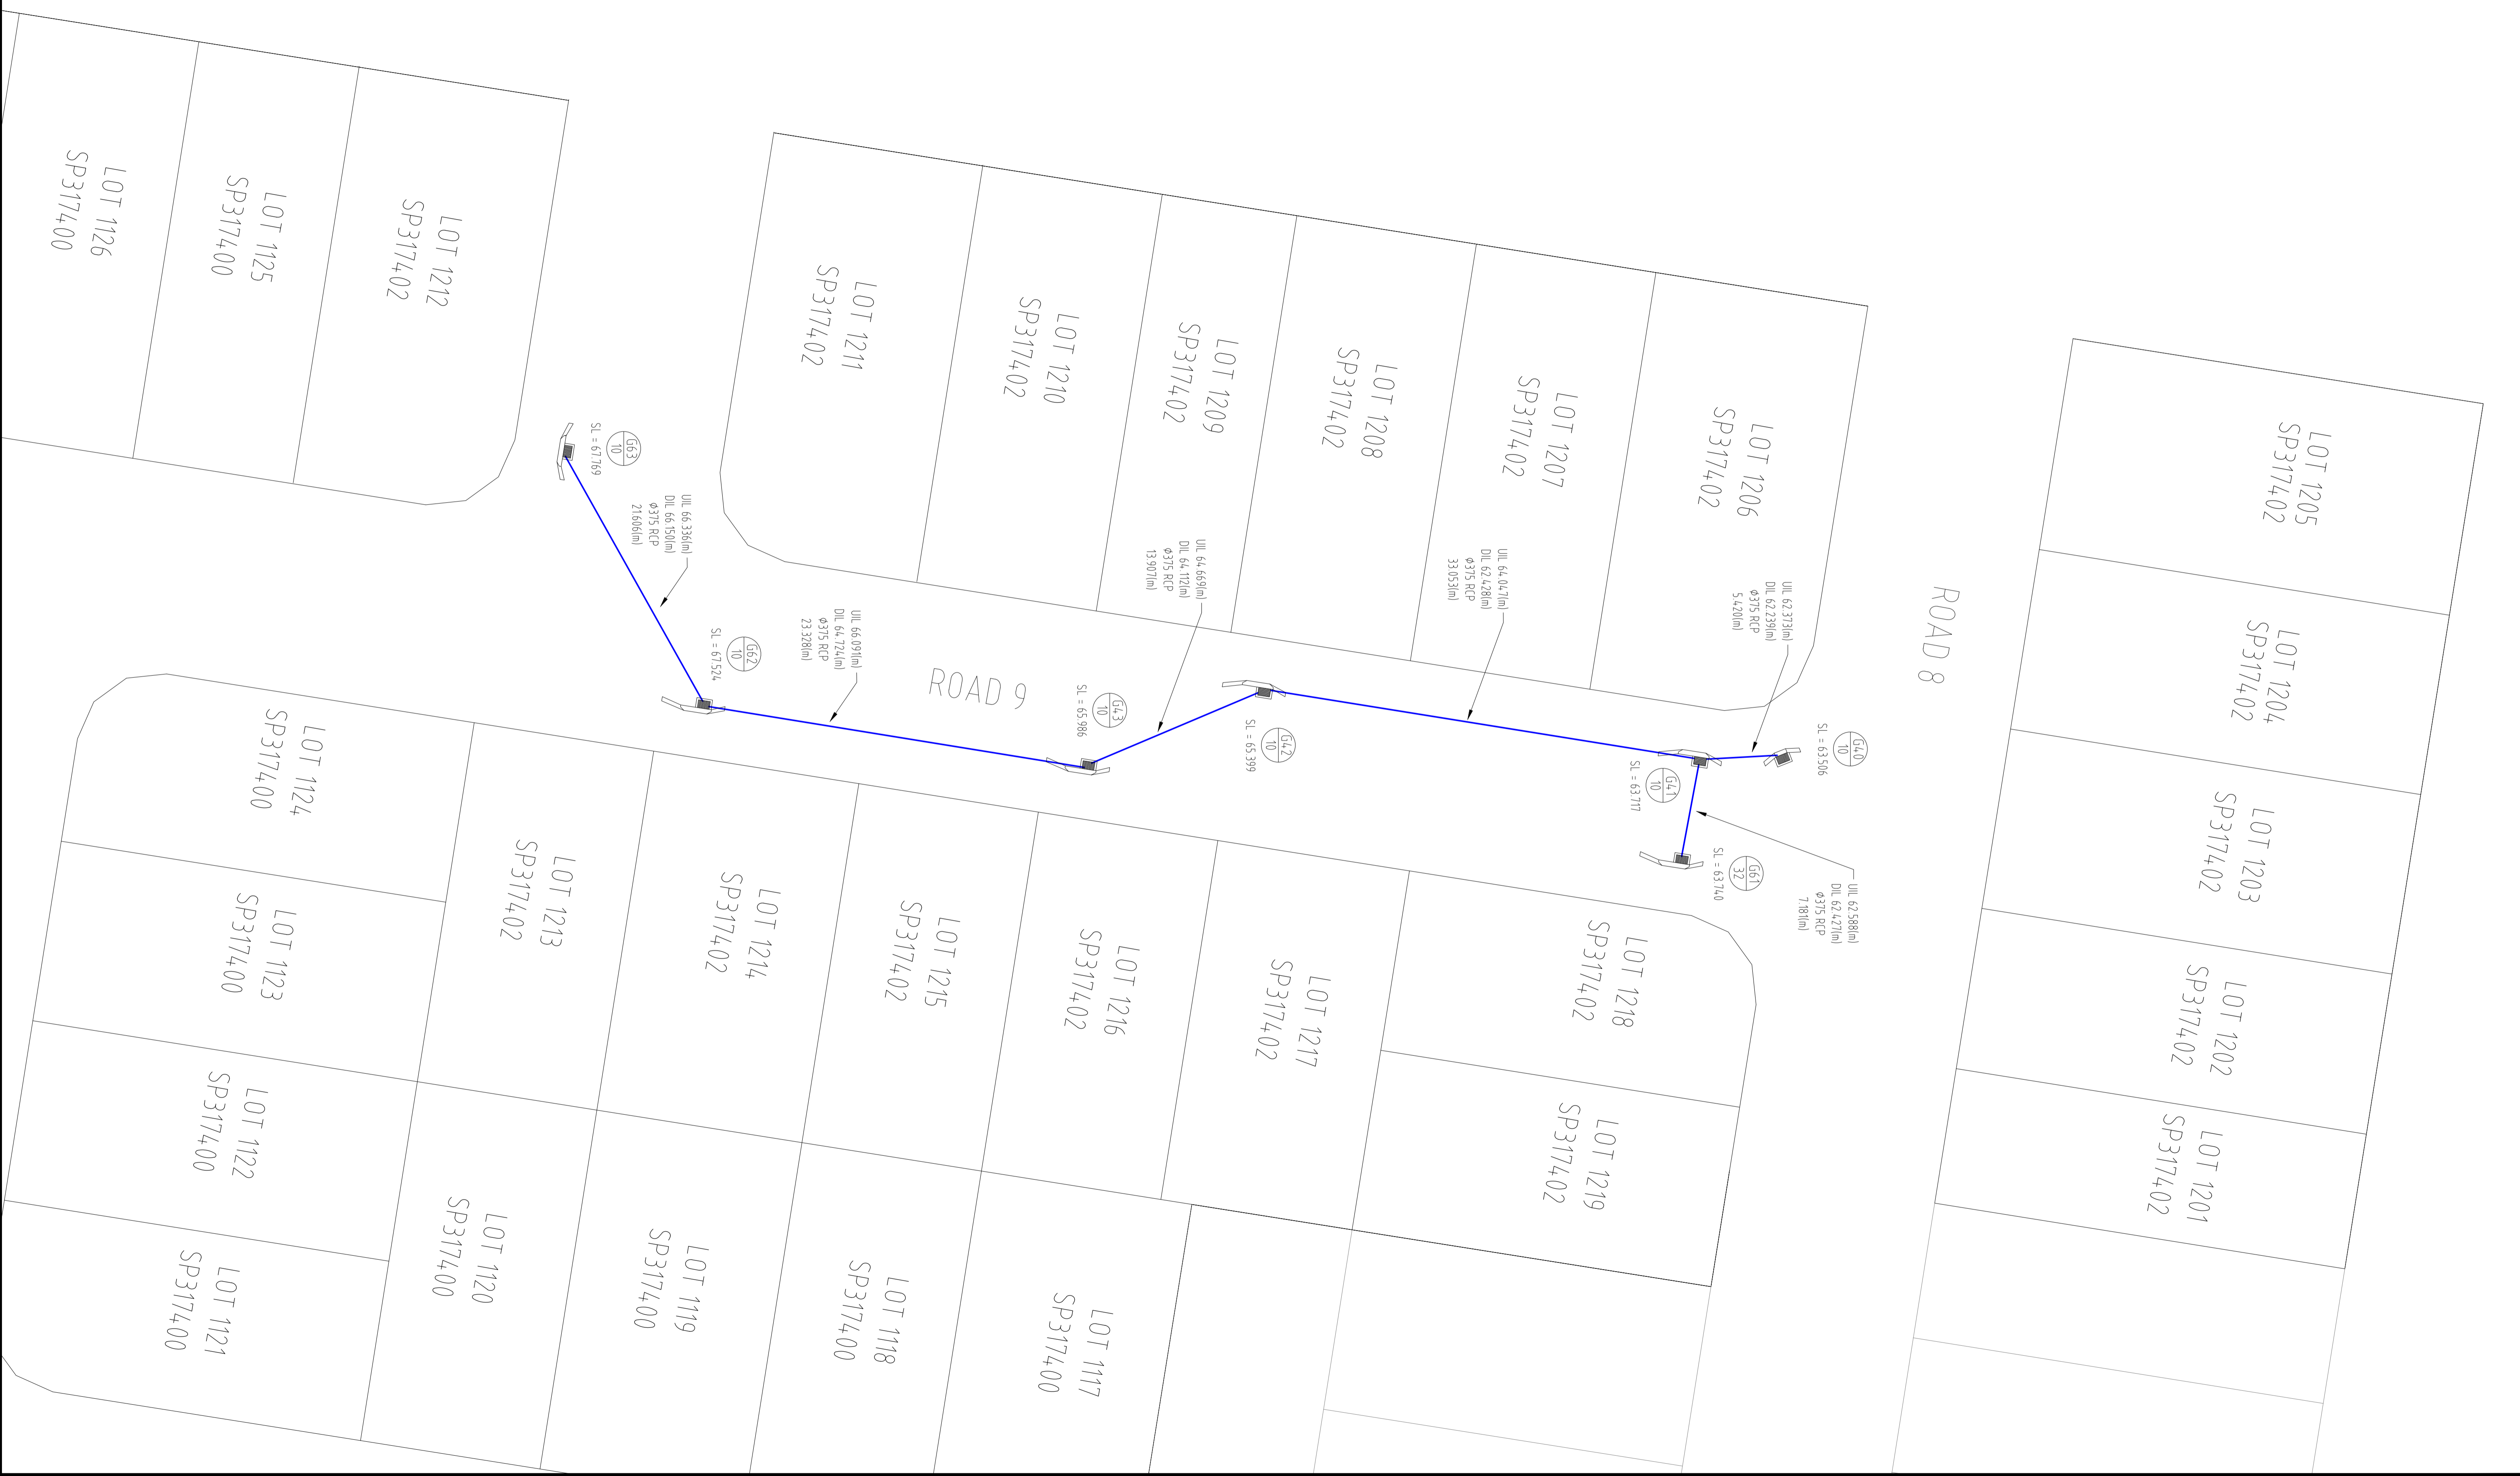

A1

INDEX	DATE	REVISIONS	DRAWN	CHECKED	PASSED
A	24/10/2022	AS CONSTRUCTED	MW	DAM	

DRAWN	MW	DATE
CHECKED	DAM	24/10/2022
PASSED		



Ipswich City Council
 8509/2021/PDA
 AS CONSTRUCTED SURVEY - STORMWATER
 RIPLEY VALLEY, STAGE 12
 QLD

SHEET 1 OF 1 SHEETS	SCALE 1:250
REVISION DATE 24/10/2022	REVISION A
DISCIPLINE CODE -	
DRAWING NO. ICC-2126-ST12-SW01	