



PSM  
E:  
N:  
RL: m

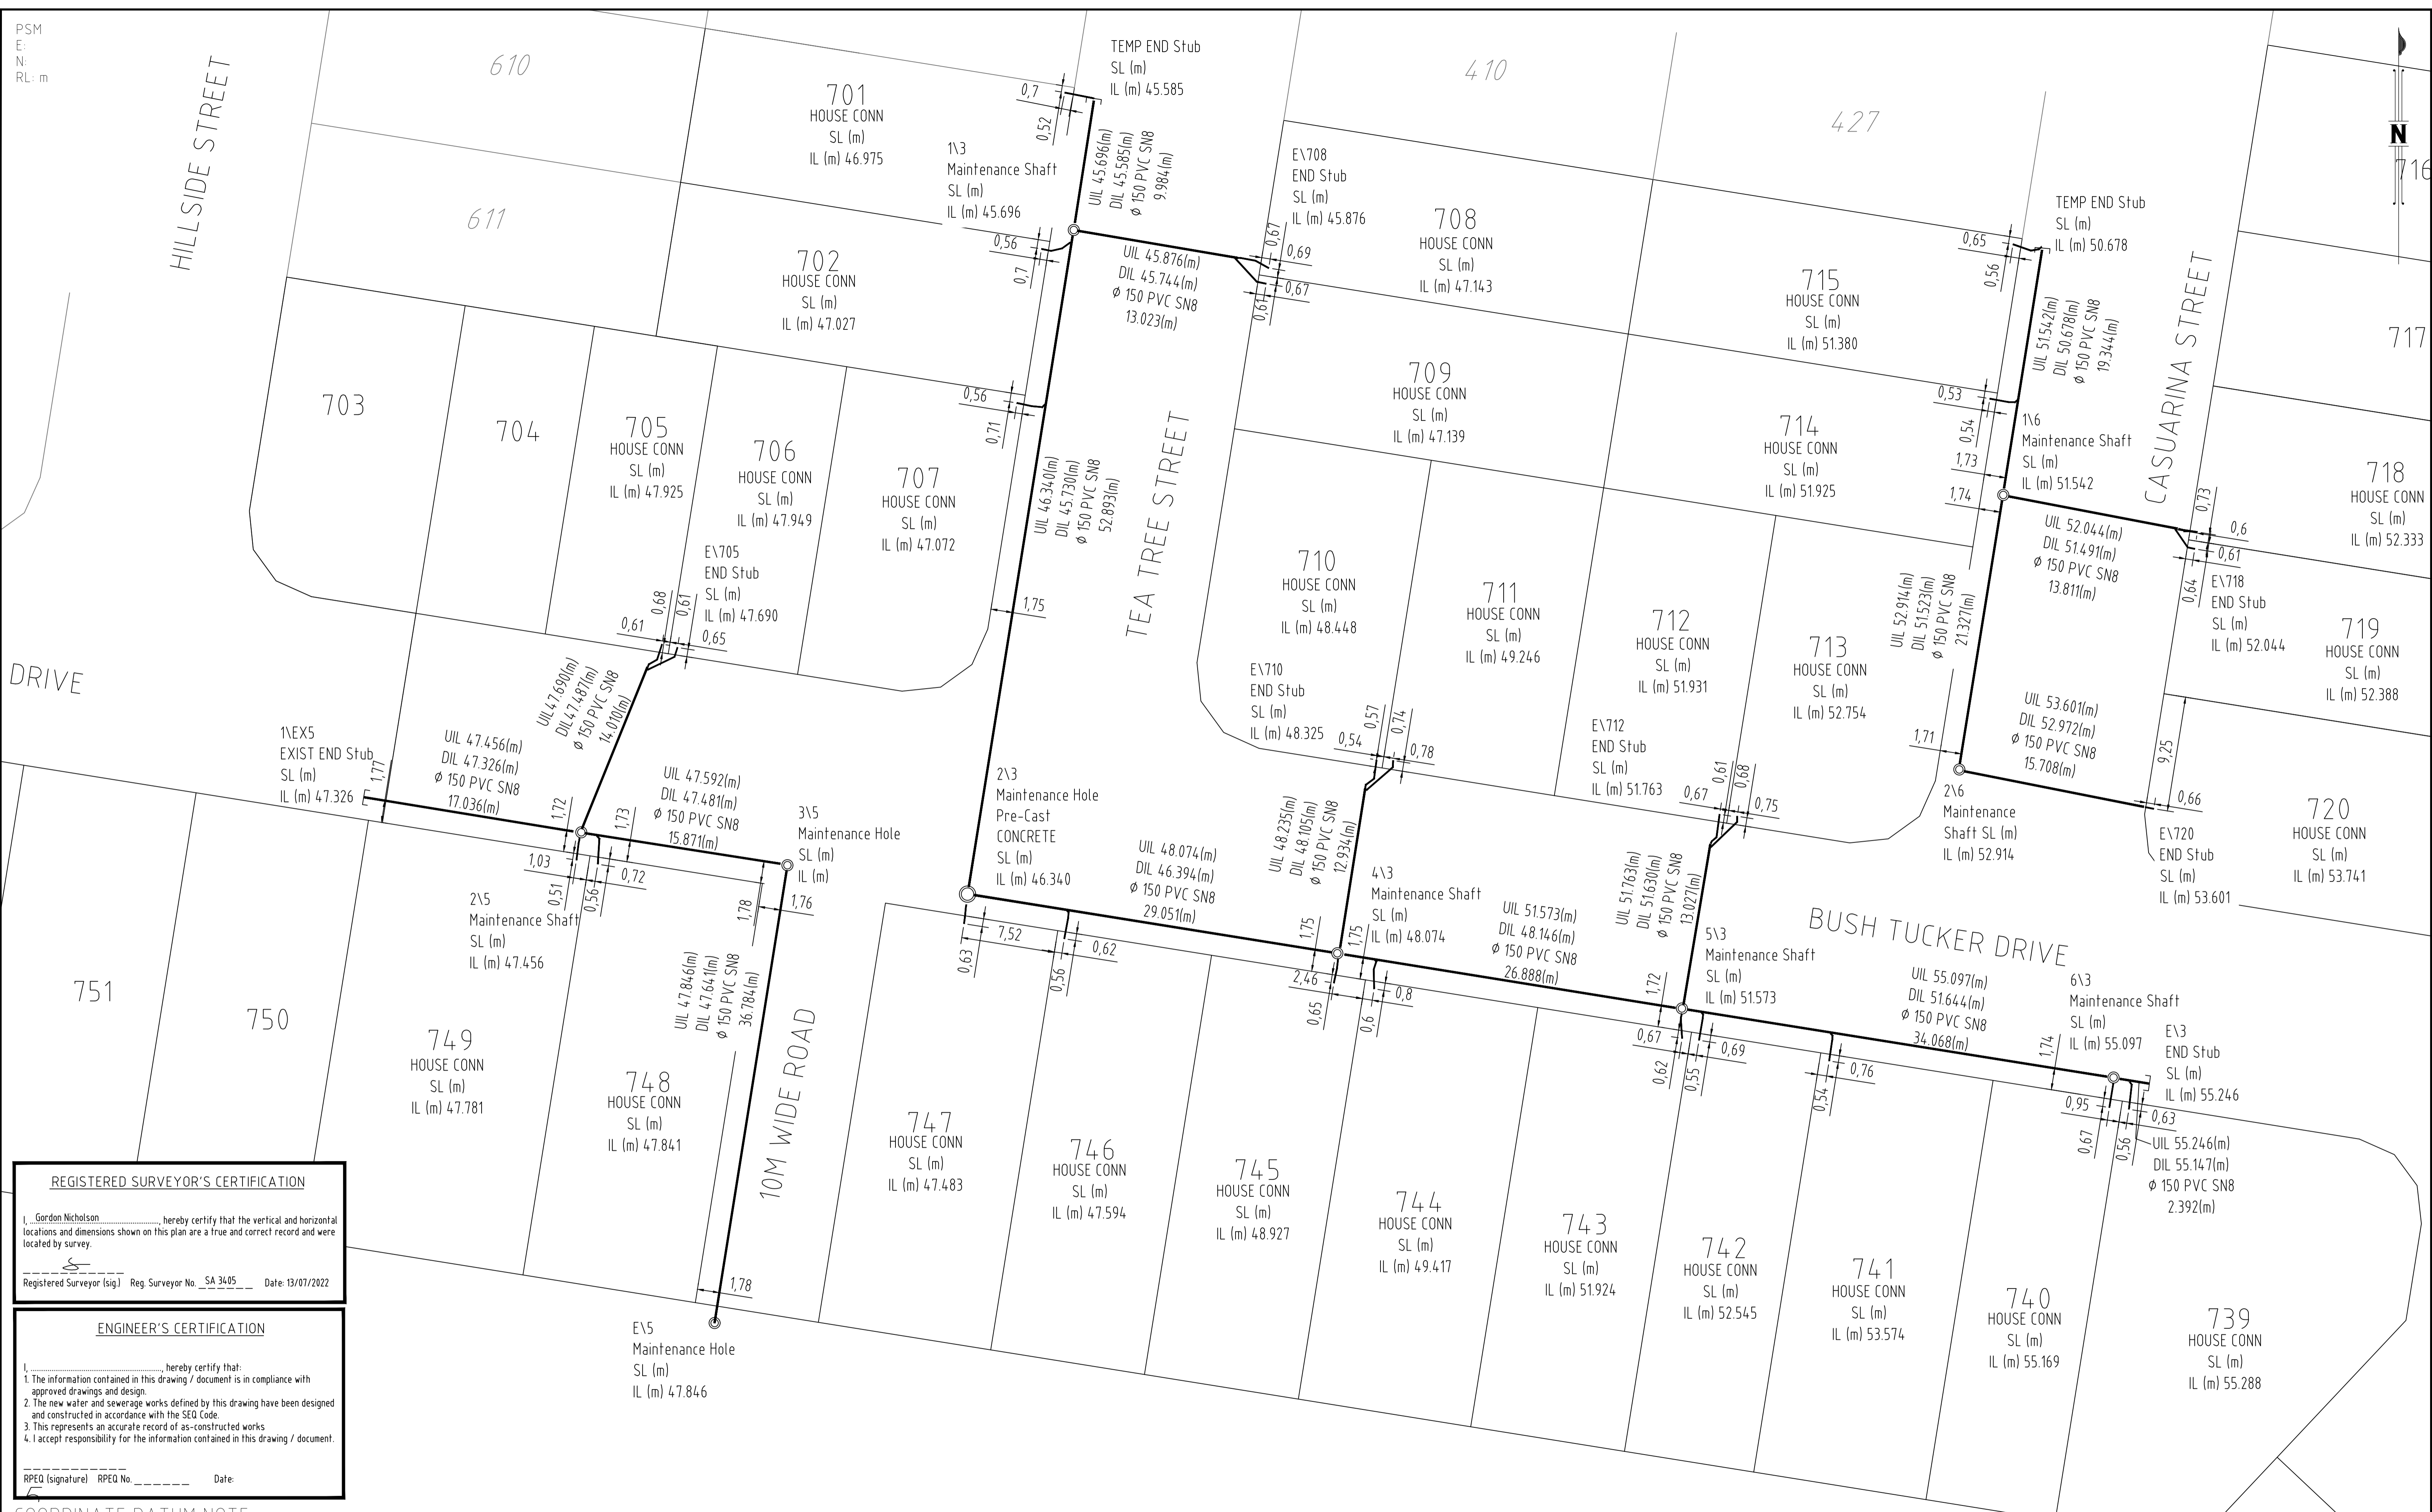

**REGISTERED SURVEYOR'S CERTIFICATION**  
I, Gordon Nicholson, hereby certify that the vertical and horizontal locations and dimensions shown on this plan are a true and correct record and were located by survey.  
Registered Surveyor (sig) Reg. Surveyor No. SA 3405 Date: 13/07/2022

**ENGINEER'S CERTIFICATION**  
I, \_\_\_\_\_, hereby certify that:  
1. The information contained in this drawing / document is in compliance with approved drawings and design.  
2. The new water and sewerage works defined by this drawing have been designed and constructed in accordance with the SEQ Code.  
3. This represents an accurate record of as-constructed works  
4. I accept responsibility for the information contained in this drawing / document.  
RPEQ (signature) RPEQ No. \_\_\_\_\_ Date: \_\_\_\_\_

**COORDINATE DATUM NOTE:**  
HORIZONTAL COORDINATES(E,N) SUPPLIED ARE MAPPING GRID OF AUSTRALIA(MGA), ZONE 56 BASED ON THE UNIVERSAL TRANSVERSE MERCATOR PROJECTION AND THE GEOCENTRIC DATUM OF AUSTRALIA 2020.

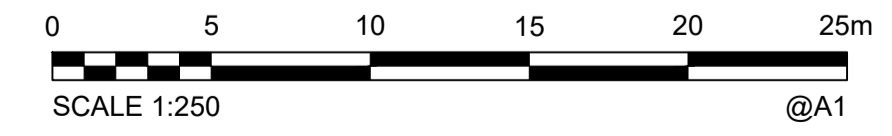


**AS CONSTRUCTED**

<b>A1</b>	INDEX	DATE	AS CONSTRUCTED	SM	DAM	DP	DRAWN	CHECKED	PASSED	INITIALS	DATE
	A	13-07-2022	AS CONSTRUCTED	SM	DAM	DP	SM	DAM	DP		13-07-2022

**Unitywater**  
UNITY WATER WORKING ID#  
AS CONSTRUCTED SURVEY - SEWER  
RIDGEVIEW STAGE 7  
NARANGBA QLD

SHEET 1 OF 3 SHEETS	SCALE 1:250 A1
REVISION DATE 13-07-2022	REVISION <b>A</b>
DISCIPLINE CODE	
DRAWING NO.	
U-ASCON-SEW-01-2188-7	



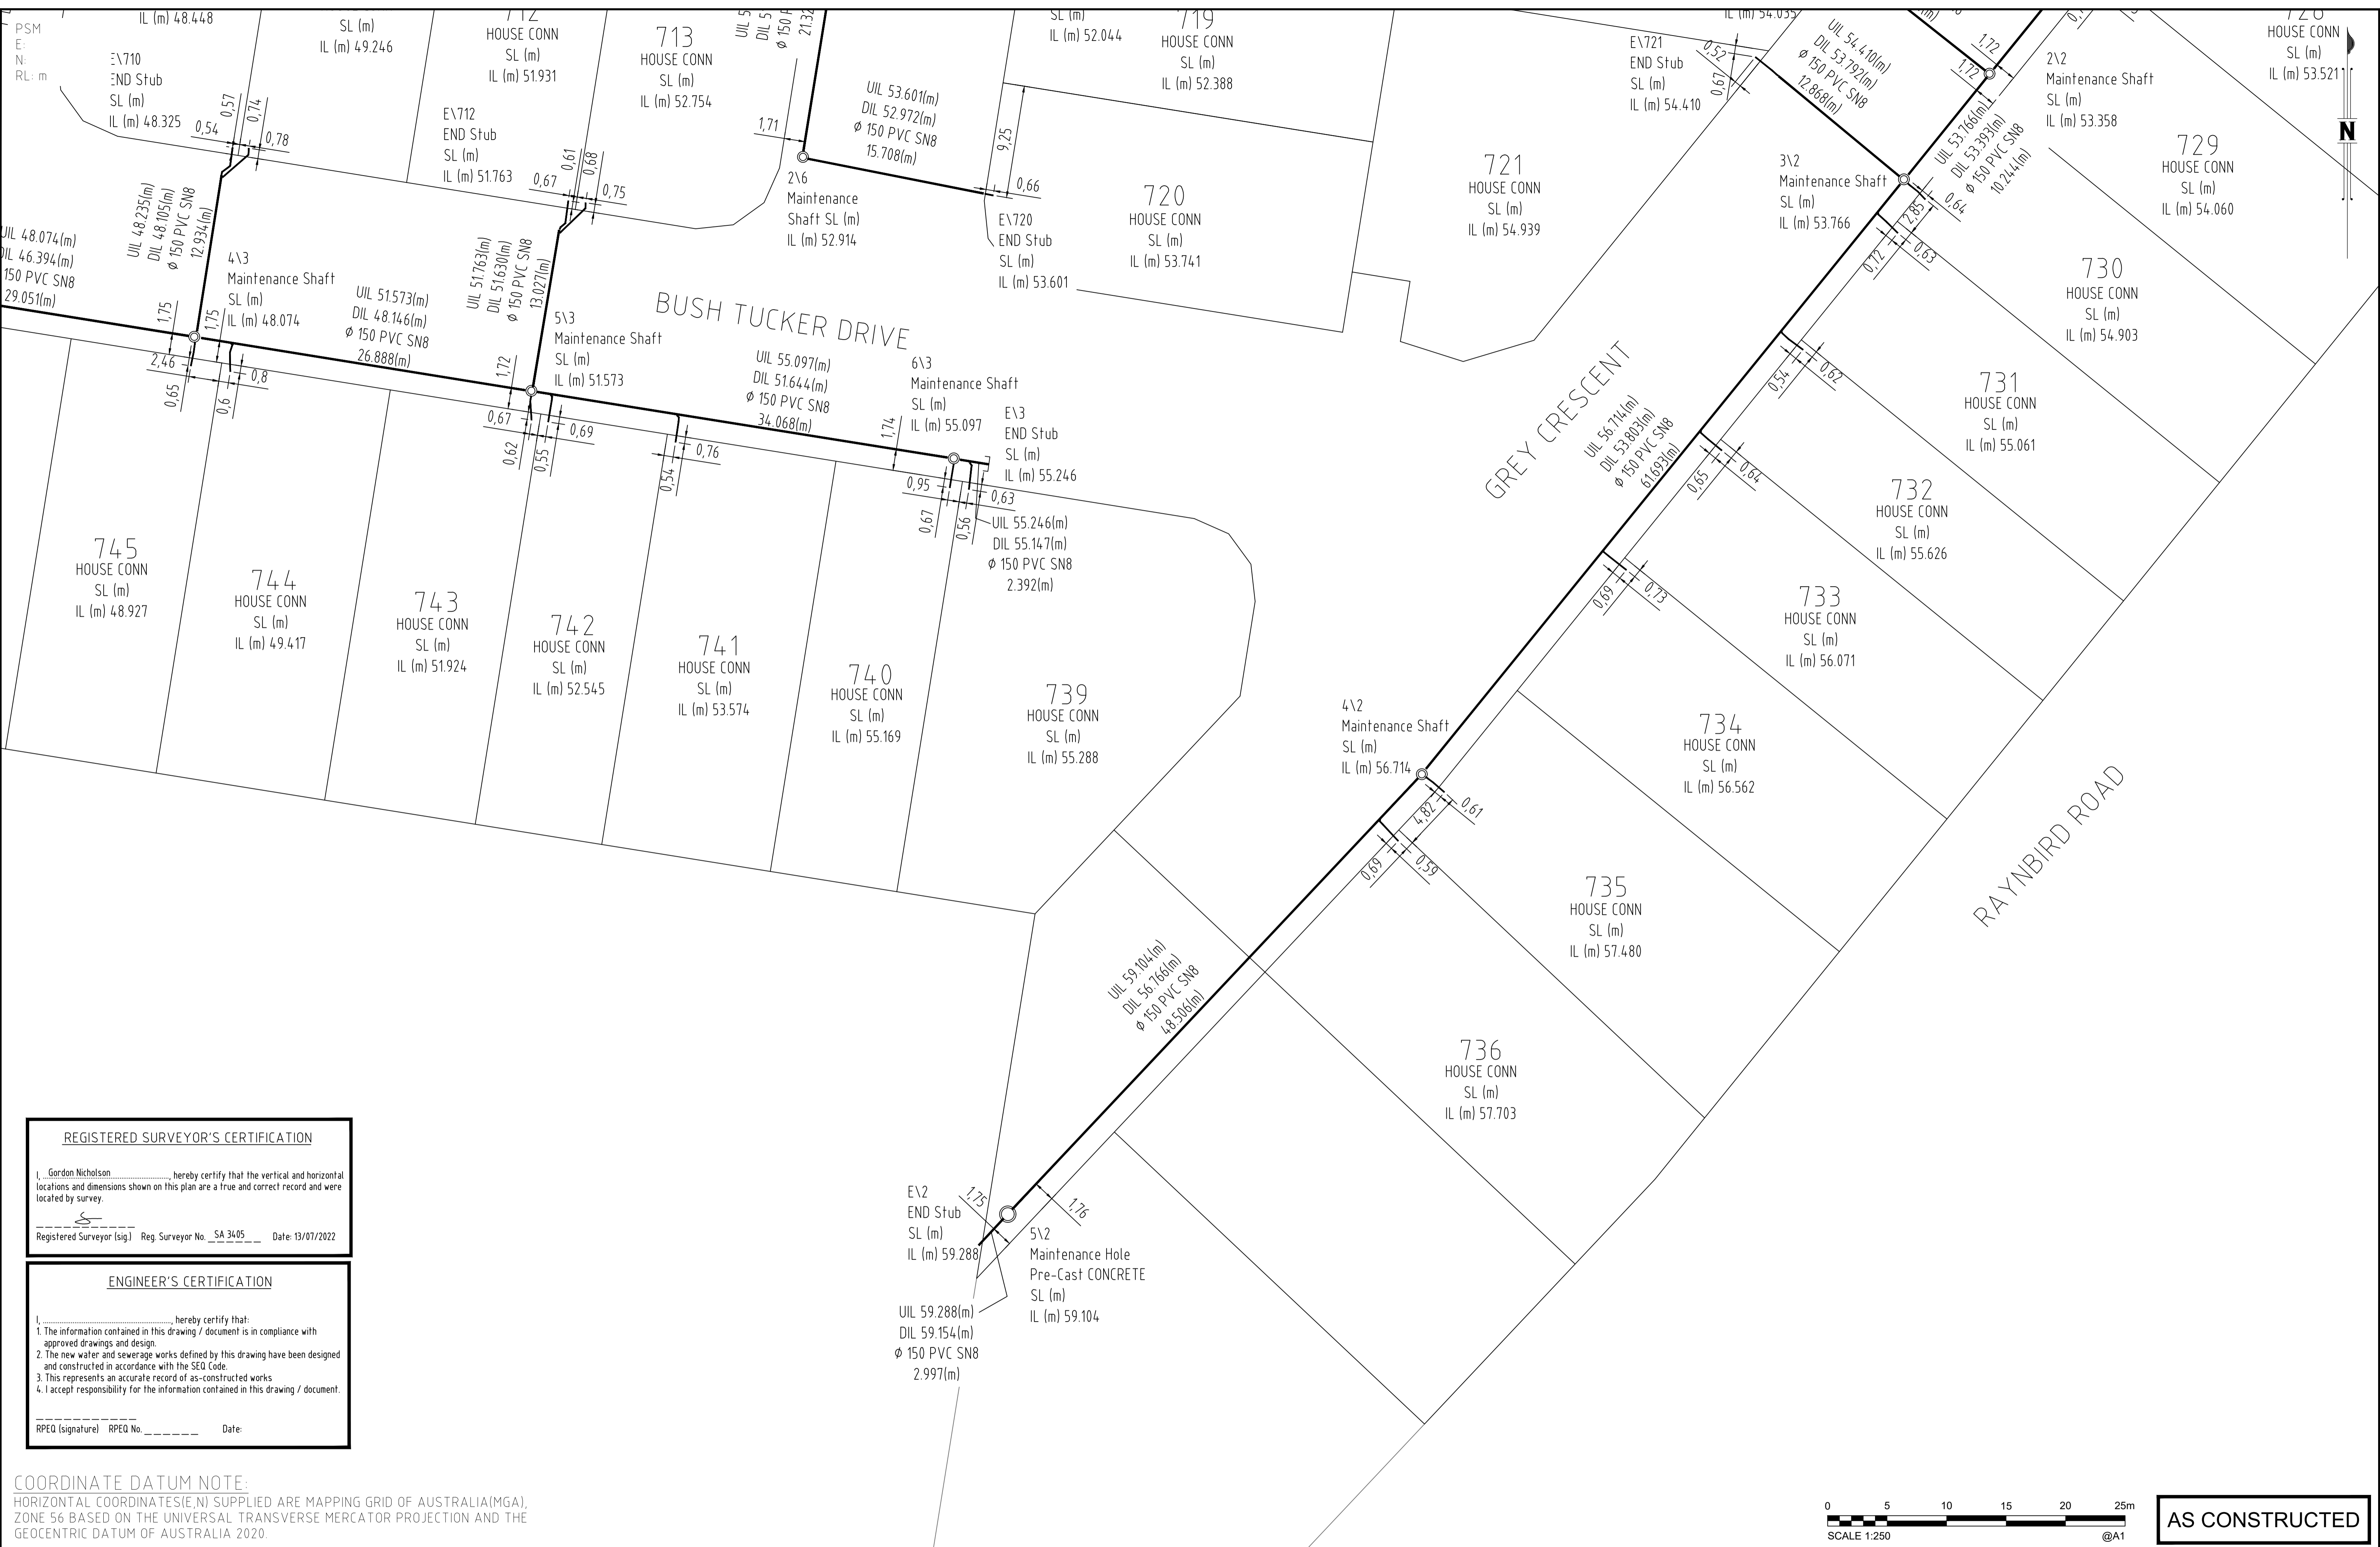

**REGISTERED SURVEYOR'S CERTIFICATION**

I, Gordon Nicholson, hereby certify that the vertical and horizontal locations and dimensions shown on this plan are a true and correct record and were located by survey.

Registered Surveyor (sig) Reg. Surveyor No. SA 3405 Date: 13/07/2022

**ENGINEER'S CERTIFICATION**

I, \_\_\_\_\_, hereby certify that:

- The information contained in this drawing / document is in compliance with approved drawings and design.
- The new water and sewerage works defined by this drawing have been designed and constructed in accordance with the SEQ Code.
- This represents an accurate record of as-constructed works
- I accept responsibility for the information contained in this drawing / document.

RPEQ (signature) RPEQ No. \_\_\_\_\_ Date: \_\_\_\_\_

**COORDINATE DATUM NOTE:**  
 HORIZONTAL COORDINATES (E,N) SUPPLIED ARE MAPPING GRID OF AUSTRALIA (MGA), ZONE 56 BASED ON THE UNIVERSAL TRANSVERSE MERCATOR PROJECTION AND THE GEOCENTRIC DATUM OF AUSTRALIA 2020.



**AS CONSTRUCTED**

A1	INDEX	DATE	REVISIONS	DRAWN	CHECKED	PASSED	INITIALS	DATE
	A	13-07-2022	AS CONSTRUCTED	SM	DAM	DP		

DRAWN	SM	13-07-2022
CHECKED	DAM	13-07-2022
PASSED	DP	13-07-2022





**Unitywater**

UNITY WATER WORKING ID#  
 AS CONSTRUCTED SURVEY - SEWER  
 RIDGEVIEW STAGE 7  
 NARANGBA QLD

SHEET 2 OF 3 SHEETS	SCALE 1:250 A1
REVISION DATE 13-07-2022	REVISION <b>A</b>
DISCIPLINE CODE	
DRAWING NO.	
U-ASCON-SEW-02-2188-7	




PSM  
E:  
N:  
RL: m

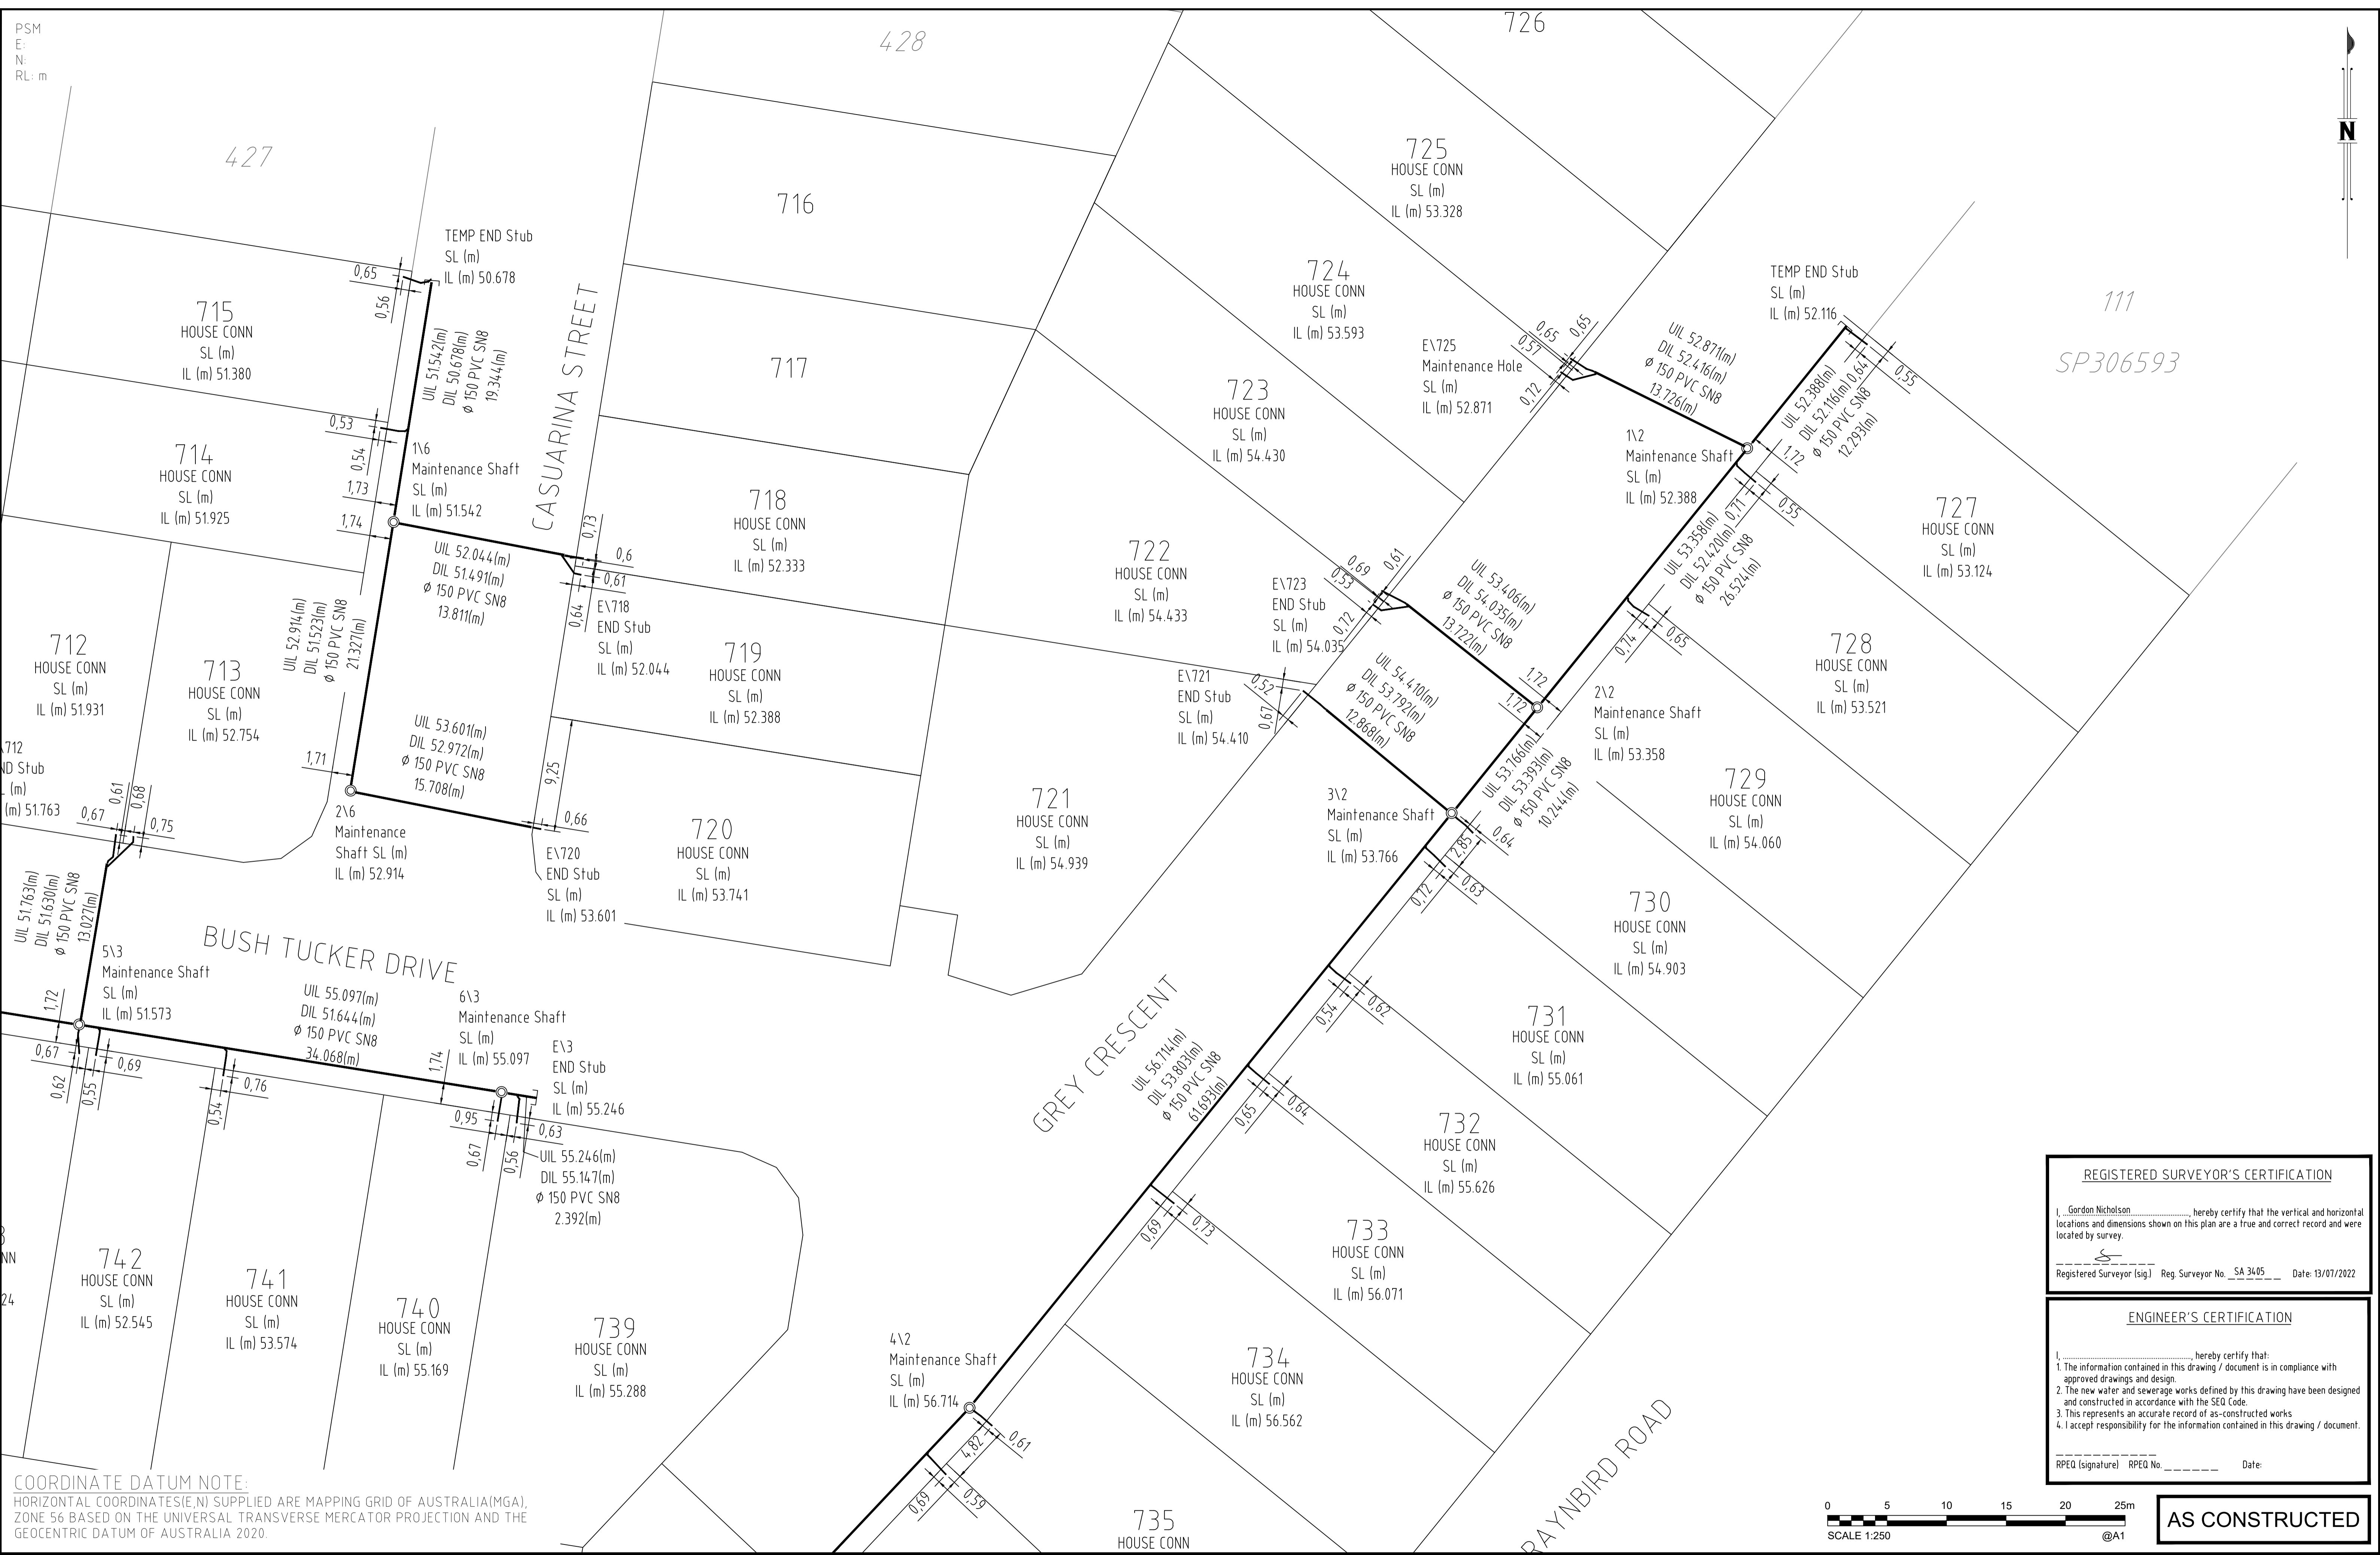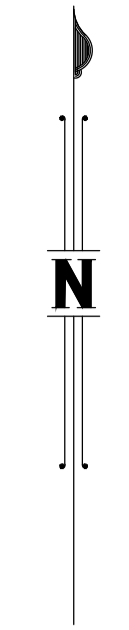

111  
SP306593

**REGISTERED SURVEYOR'S CERTIFICATION**  
 I, Gordon Nicholson, hereby certify that the vertical and horizontal locations and dimensions shown on this plan are a true and correct record and were located by survey.  
 Registered Surveyor (Sig) \_\_\_\_\_ Reg. Surveyor No. SA 3405 Date: 13/07/2022

**ENGINEER'S CERTIFICATION**  
 I, \_\_\_\_\_, hereby certify that:  
 1. The information contained in this drawing / document is in compliance with approved drawings and design.  
 2. The new water and sewerage works defined by this drawing have been designed and constructed in accordance with the SEQ Code.  
 3. This represents an accurate record of as-constructed works  
 4. I accept responsibility for the information contained in this drawing / document.  
 RPEQ (signature) \_\_\_\_\_ RPEQ No. \_\_\_\_\_ Date: \_\_\_\_\_

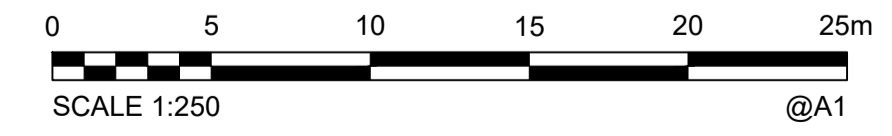

**AS CONSTRUCTED**

**COORDINATE DATUM NOTE:**  
 HORIZONTAL COORDINATES (E,N) SUPPLIED ARE MAPPING GRID OF AUSTRALIA (MGA), ZONE 56 BASED ON THE UNIVERSAL TRANSVERSE MERCATOR PROJECTION AND THE GEOCENTRIC DATUM OF AUSTRALIA 2020.

A1	A	13-07-2022	AS CONSTRUCTED	SM	DAM	DP	PASSED	DP	13-07-2022
	INDEX	DATE	REVISIONS	DRAWN	CHECKED	PASSED	INITIALS	DATE	

DRAWN	SM	13-07-2022
CHECKED	DAM	13-07-2022
PASSED	DP	13-07-2022



**Unitywater**  
 UNITY WATER WORKING ID#  
 AS CONSTRUCTED SURVEY - SEWER  
 RIDGEVIEW STAGE 7  
 NARANGBA QLD

SHEET 3 OF 3 SHEETS	SCALE 1:250 A1
REVISION DATE 13-07-2022	REVISION A
DISCIPLINE CODE	
DRAWING NO.	
U-ASCON-SEW-03-2188-7	