




ENGINEER'S CERTIFICATION
 I, Troy Schultz, being a Certified/ Registered Engineer and duly authorised representative of PEAKURBAN Pty Ltd, hereby certify the information contained in this drawing as generally an accurate "As Constructed" representation of the works.
 RPEQ (Signature) 20631 Date: 23/05/2021
 RPEQ No.

REGISTERED SURVEYOR'S CERTIFICATION
 PATRICK KENNY hereby certify that the vertical and horizontal locations and dimensions shown on this plan are a true and correct record and were located by survey.
 Graduate Surveyor (sig.) Reg. Surveyor No. 6240 Date: 11/05/2022

COORDINATE DATUM NOTE:
 HORIZONTAL COORDINATES(E,N) SUPPLIED ARE MAPPING GRID OF AUSTRALIA(MGA), ZONE 56 BASED ON THE UNIVERSAL TRANSVERSE MERCATOR PROJECTION AND THE GEOCENTRIC DATUM OF AUSTRALIA 2020.

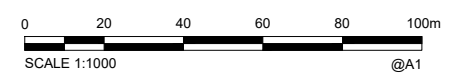

AS CONSTRUCTED


A1	A	11-05-2022	AS CONSTRUCTED	NJA	DAM	AM
	INDEX	DATE	REVISIONS	DRAWN	CHECKED	PASSED
				DRAWN	NJA	11-05-2022
				CHECKED	DAM	11-05-2022
				PASSED	AM	11-05-2022
				INITIALS	DATE	



Unitywater
 2018012748S6_7C
 AS CONSTRUCTED SURVEY - SEWER
 RIDGEVIEW STAGES 6 - 7c
 NARANGBA QLD


SHEET 1 OF 3 SHEETS	SCALE 1:1000 A1
REVISION DATE 11-05-2022	REVISION A
DISCIPLINE CODE	
DRAWING NO. U-2021-3814-S6-S1	

COORDINATE DATUM NOTE:
 HORIZONTAL COORDINATES (E,N) SUPPLIED ARE MAPPING GRID OF AUSTRALIA (MGA), ZONE 56 BASED ON THE UNIVERSAL TRANSVERSE MERCATOR PROJECTION AND THE GEOCENTRIC DATUM OF AUSTRALIA 2020.
 HORIZONTAL DATUM DERIVED FROM PSM 101150 E 4.92979.953 N 6993158.441
 LEVELS SUPPLIED ARE ON THE AUSTRALIAN HEIGHT DATUM (AH/D)
 LEVEL DATUM DERIVED FROM PSM 101150 RL 4.7.028 (AHD)

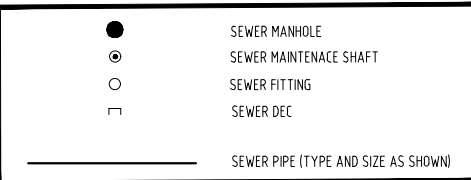

REGISTERED SURVEYOR'S CERTIFICATION
 I, PATRICK KENNY, hereby certify that the vertical and horizontal locations and dimensions shown on this plan are a true and correct record and were located by survey.
 Graduate Surveyor (sig) Reg. Surveyor No. 6240 Date: 11/05/2022

ENGINEER'S CERTIFICATION
 I, Troy Schultz, being a Certified/ Registered Engineer and duly authorised representative of PEAKURBAN Pty Ltd, hereby, certify the information contained in this drawing as generally an accurate "As Constructed" representation of the works.
 RPEQ (Signature) 20631 RPEQ No. Date: 23/05/2021
 For and on behalf of PEAKURBAN Pty Ltd. In making this certificate we have relied upon information provided by others.

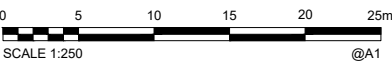

PSM 101150
 E: 4.92979.953
 N: 6993158.441
 RL: 4.7.028m

AS CONSTRUCTED

A1

INDEX	DATE	REVISIONS	DRAWN	CHECKED	PASSED
A	11-05-2022	AS CONSTRUCTED SEWER	NJA	DAM	AM

DRAWN	CHECKED	PASSED	INITIALS	DATE
NJA	DAM	AM		11-05-2022
				11-05-2022
				11-05-2022




Unitywater

201801274856_7C
 AS CONSTRUCTED SURVEY - SEWER
 RIDGEVIEW STAGES 6 - 7c
 NARANGBA QLD


SHEET 2 OF 3 SHEETS	SCALE 1:250 A1
REVISION DATE 11-05-2022	REVISION A
DISCIPLINE CODE	
DRAWING NO. U-2021-3814-S6-S2	

COORDINATE DATUM NOTE:
 HORIZONTAL COORDINATES (E, N) SUPPLIED ARE MAPPING GRID OF AUSTRALIA (MGA), ZONE 56 BASED ON THE UNIVERSAL TRANSVERSE MERCATOR PROJECTION AND THE GEOCENTRIC DATUM OF AUSTRALIA 2020.
 HORIZONTAL DATUM DERIVED FROM PSM 101150 E 4.92979.953 N 6993158.441.
 LEVELS SUPPLIED ARE ON THE AUSTRALIAN HEIGHT DATUM (AHD)
 LEVEL DATUM DERIVED FROM PSM 101150 RL 4.7028 (AHD)

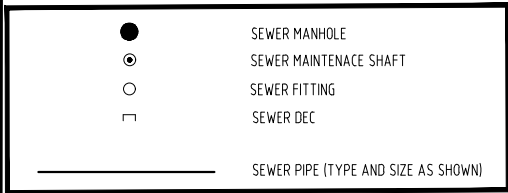

REGISTERED SURVEYOR'S CERTIFICATION
 I, PATRICK KENNY, hereby certify that the vertical and horizontal locations and dimensions shown on this plan are a true and correct record and were located by survey.
 Graduate Surveyor (sig) Reg. Surveyor No. 6240 Date: 11/05/2022

ENGINEER'S CERTIFICATION
 I, Troy Schultz, being a Certified/Registered Engineer and duly authorised representative of PEAKURBAN Pty Ltd, hereby certify the information contained in this drawing as generally an accurate "As Constructed" representation of the works.
 RPEQ (Signature) 20631 RPEQ No. Date: 23/05/2021
 For and on behalf of PEAKURBAN Pty Ltd. In making this certificate we have relied upon information provided by others.

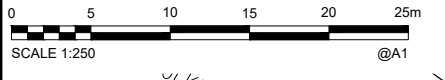

PSM 101150
 E: 4.92979.953
 N: 6993158.441
 RL: 4.7028m

AS CONSTRUCTED

A1

INDEX	DATE	REVISIONS	DRAWN	CHECKED	PASSED
A	11-05-2022	AS CONSTRUCTED SEWER	NJA	DAM	AM

DRAWN	INITIALS	DATE
DRAWN	NJA	11-05-2022
CHECKED	DAM	11-05-2022
PASSED	AM	11-05-2022



Unitywater
 201801274856_7C
 AS CONSTRUCTED SURVEY - SEWER
 RIDGEVIEW STAGES 6 - 7c
 NARANGBA QLD

SHEET 3 OF 3 SHEETS	SCALE 1:250 A1
REVISION DATE 11-05-2022	REVISION A
DISCIPLINE CODE	
DRAWING NO.	
U-2021-3814-S6-S3	

PSM 101150
 E: 492979.953
 N: 6993458.441
 RL: 47.028m




ENGINEER'S CERTIFICATION

I, **Troy Schultz**, being a Certified/Registered Engineer and duly authorised representative of **PEAKURBAN Pty Ltd**, hereby certify the information contained in this drawing as generally an accurate "As Constructed" representation of the works.

RPEQ (Signature) **20631** Date: **23/05/2021**
RPEQ No.

For and on behalf of **PEAKURBAN Pty Ltd**.
 In making this certificate we have relied upon information provided by others.

AS CONSTRUCTED

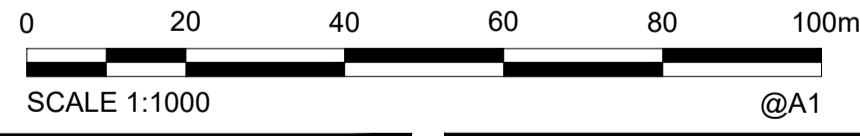

REGISTERED SURVEYOR'S CERTIFICATION

PATRICK KENNY, hereby certify that the vertical and horizontal locations and dimensions shown on this plan are a true and correct record and were located by survey.

Graduate Surveyor (sig) Reg. Surveyor No. **6240** Date: **17/05/2022**

● FHV/DFH	FIRE HYDRANT/ DUCKFOOT HYDRANT
✕ SV	STOP VALVE
⊕	WATER METER LOT
()	READY TAP
>	FITTING
—	WATER PIPE SIZE AND CLASS AS SHOWN
—	Ø100 PVC-U UPVC CONDUIT

COORDINATE DATUM NOTE:
 HORIZONTAL COORDINATES(E,N) SUPPLIED ARE MAPPING GRID OF AUSTRALIA(MGA), ZONE 56
 BASED ON THE UNIVERSAL TRANSVERSE MERCATOR PROJECTION AND THE GEOCENTRIC DATUM OF AUSTRALIA 2020.
 HORIZONTAL DATUM DERIVED FROM PSM 101150 E 492979.953 N 6993458.441
 LEVELS SUPPLIED ARE ON THE AUSTRALIAN HEIGHT DATUM(AHD)
 LEVEL DATUM DERIVED FROM PSM 101150 RL 47.028 (AHD)

NOTES:
 ALL SERVICE CONNECTIONS ARE Ø25 PE 100 PN16

A1

INDEX	DATE	REVISIONS	DRAWN	CHECKED	PASSED
A	17/05/2022	AS CONSTRUCTED	NJA	DAM	AM

DRAWN	NJA	17/05/2022
CHECKED	DAM	17/05/2022
PASSED	AM	17/05/2022
INITIALS		DATE



Unitywater
 201801274856_7C
 AS CONSTRUCTED SURVEY - WATER
 RIDGEVIEW STAGE 5A
 NARANGBA QLD

SHEET 1 OF 3 SHEETS	SCALE 1:1000 A1
REVISION DATE 17/05/2022	REVISION A
DISCIPLINE CODE -	
DRAWING NO. U-2021-3814-S6-W1	

ENGINEER'S CERTIFICATION

I, **Troy Schultz**, being a Certified/ Registered Engineer and duly authorised representative of **PEAKURBAN Pty Ltd**, hereby, certify the information contained in this drawing as generally an accurate "As Constructed" representation of the works.

RPEQ (Signature) **20631** Date: **23/05/2021**
RPEQ No.

For and on behalf of **PEAKURBAN Pty Ltd**.
In making this certificate we have relied upon information provided by others.

NOTES:

ALL SERVICE CONNECTIONS ARE $\phi 25$ PE 100 PN16

PSM 101150
E: 492979.953
N: 6993458.441
RL: 47.028m

REGISTERED SURVEYOR'S CERTIFICATION

I, **PATRICK KENNY**, hereby certify that the vertical and horizontal locations and dimensions shown on this plan are a true and correct record and were located by survey.

Graduate Surveyor (sig) Reg. Surveyor No. **6240** Date: **17/05/2022**

- FIRE HYDRANT/ DUCKFOOT HYDRANT
- STOP VALVE
- WATER METER LOT
- READY TAP
- FITTING
- WATER PIPE SIZE AND CLASS AS SHOWN
- $\phi 100$ PVC-U UPVC CONDUIT

COORDINATE DATUM NOTE:

HORIZONTAL COORDINATES (E, N) SUPPLIED ARE MAPPING GRID OF AUSTRALIA (MGA), ZONE 56 BASED ON THE UNIVERSAL TRANSVERSE MERCATOR PROJECTION AND THE GEOCENTRIC DATUM OF AUSTRALIA 2020.

HORIZONTAL DATUM DERIVED FROM PSM 101150 E 492979.953
N 6993458.441

LEVELS SUPPLIED ARE ON THE AUSTRALIAN HEIGHT DATUM (AHD)
LEVEL DATUM DERIVED FROM PSM 101150 RL 47.028 (AHD)



SCALE 1:250 @A1

AS CONSTRUCTED



A1	INDEX	DATE	REVISIONS	DRAWN	CHECKED	PASSED	INITIALS	DATE		Unitywater 201801274856_7C AS CONSTRUCTED SURVEY - WATER RIDGEVIEW STAGE 6 AND 7C NARANGBA QLD	SHEET 2 OF 3 SHEETS	SCALE 1:250 A1
	A	22/12/2021	AS CONSTRUCTED	NJA	DAM	AM					REVISION A	
											DISCIPLINE CODE -	
											DRAWING NO. U-2021-3814-S6-W2	

