


PSM 101150
 E: 492979.634
 N: 6993156.794
 RL: 47.028m



COORDINATE DATUM NOTE:
 HORIZONTAL COORDINATES(E,N) SUPPLIED ARE MAPPING GRID OF AUSTRALIA(MGA), ZONE 56 BASED ON THE UNIVERSAL TRANSVERSE MERCATOR PROJECTION AND THE GEOCENTRIC DATUM OF AUSTRALIA 1994.
 HORIZONTAL DATUM DERIVED FROM PSM 101150 E 492979.634 N 6993156.794.
 LEVELS SUPPLIED ARE ON THE AUSTRALIAN HEIGHT DATUM(AHD)
 LEVEL DATUM DERIVED FROM PSM 101150 RL 47.028 (AHD)

REGISTERED SURVEYOR'S CERTIFICATION
 I, PATRICK KENNY, hereby certify that the vertical and horizontal locations and dimensions shown on this plan are a true and correct record and were located by survey.
 Registered Surveyor (sig) Patrick Kenny Reg. Surveyor No. SA 6240 Date: 16/12/2021

ENGINEER'S CERTIFICATION
 I, _____, hereby certify that:
 1. The information contained in this drawing / document is in compliance with approved drawings and design.
 2. This represents an accurate record of as-constructed works
 3. I accept responsibility for the information contained in this drawing / document.
 RPEQ (signature) RPEQ No. _____ Date: _____

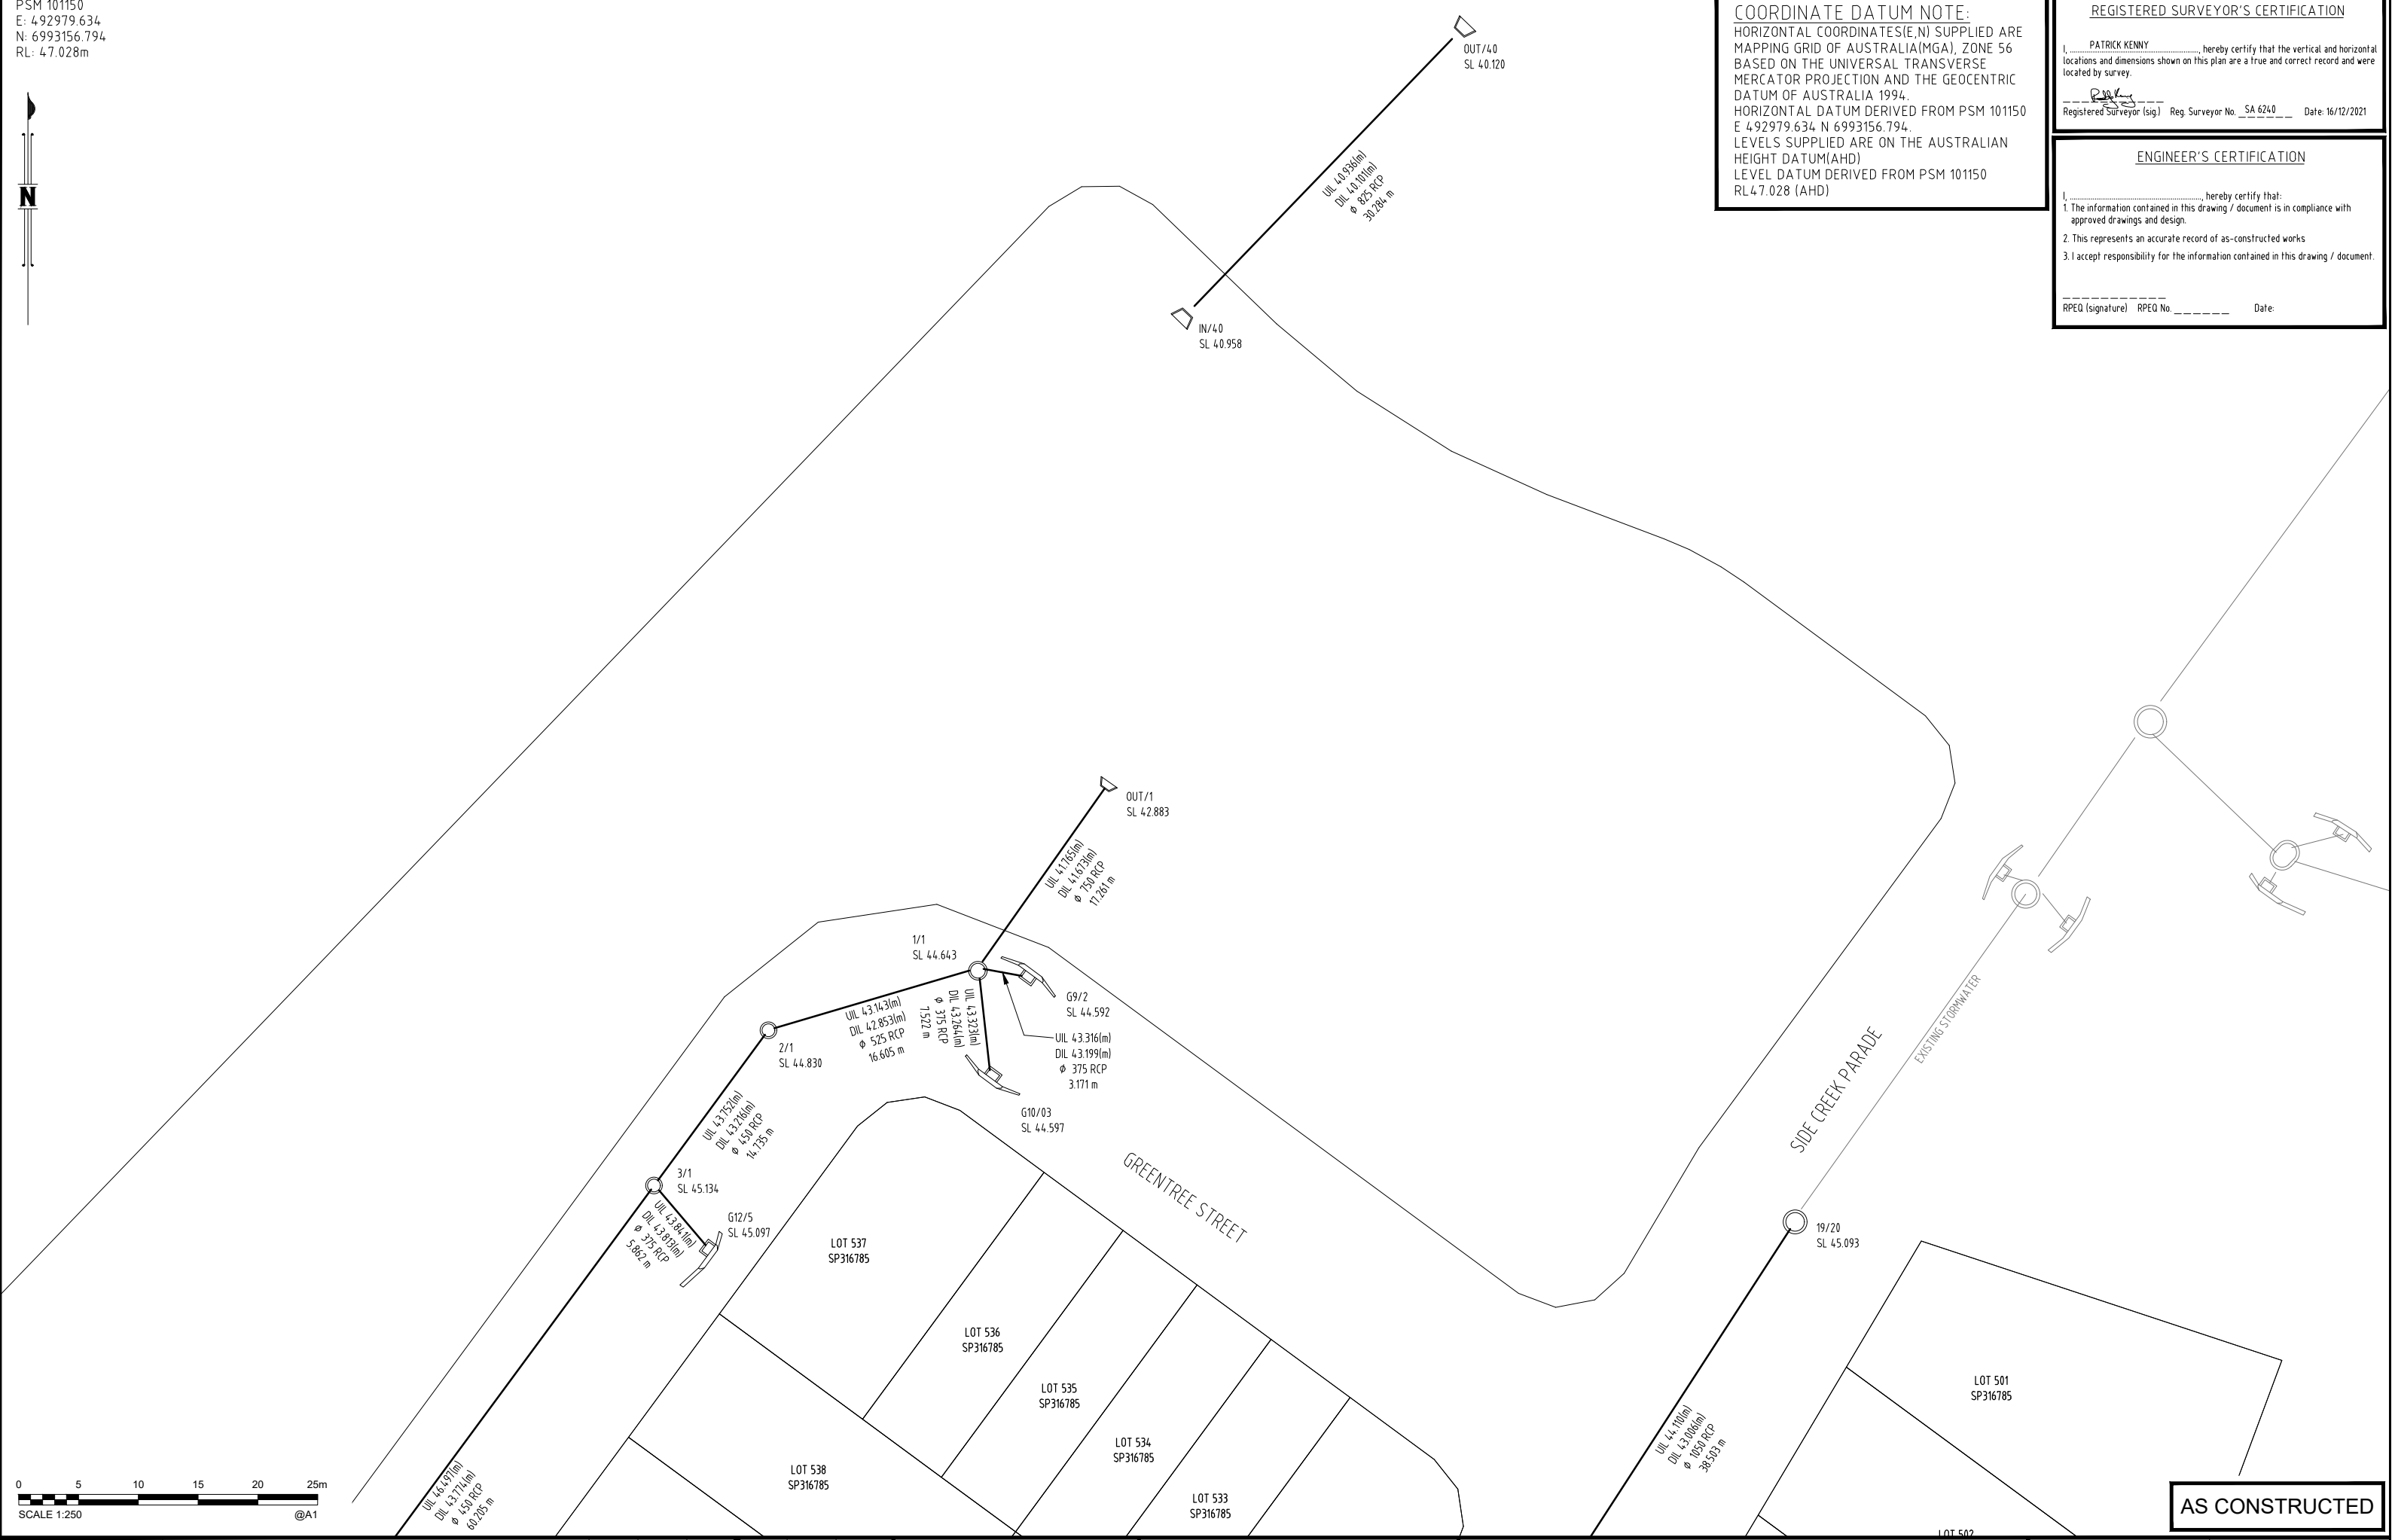

AS CONSTRUCTED

A1	INDEX	DATE	REVISIONS	DRAWN	CHECKED	PASSED	INITIALS	DATE
	-	-	-	-	-	-	-	-
	A	16/12/2021	AS CONSTRUCTED	NJA	NJA	SR		16/12/2021



DRAWN	NJA	16/12/2021
CHECKED	DAM	16/12/2021
PASSED	SR	16/12/2021



Moreton Bay Regional Council
 DA/36571/2018/V3RL
 AS CONSTRUCTED SURVEY - STORMWATER
 RIDGEVIEW STAGE 5
 NARANGBA QLD

SHEET 2 OF 4 SHEETS	SCALE 1:250
REVISION DATE 16/12/2021	REVISION A
DISCIPLINE CODE	
DRAWING NO. ASCON-STORM-02-2188-5	

PSM 101150
 E: 492979.634
 N: 6993156.794
 RL: 47.028m

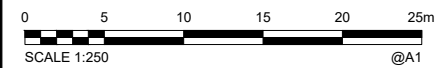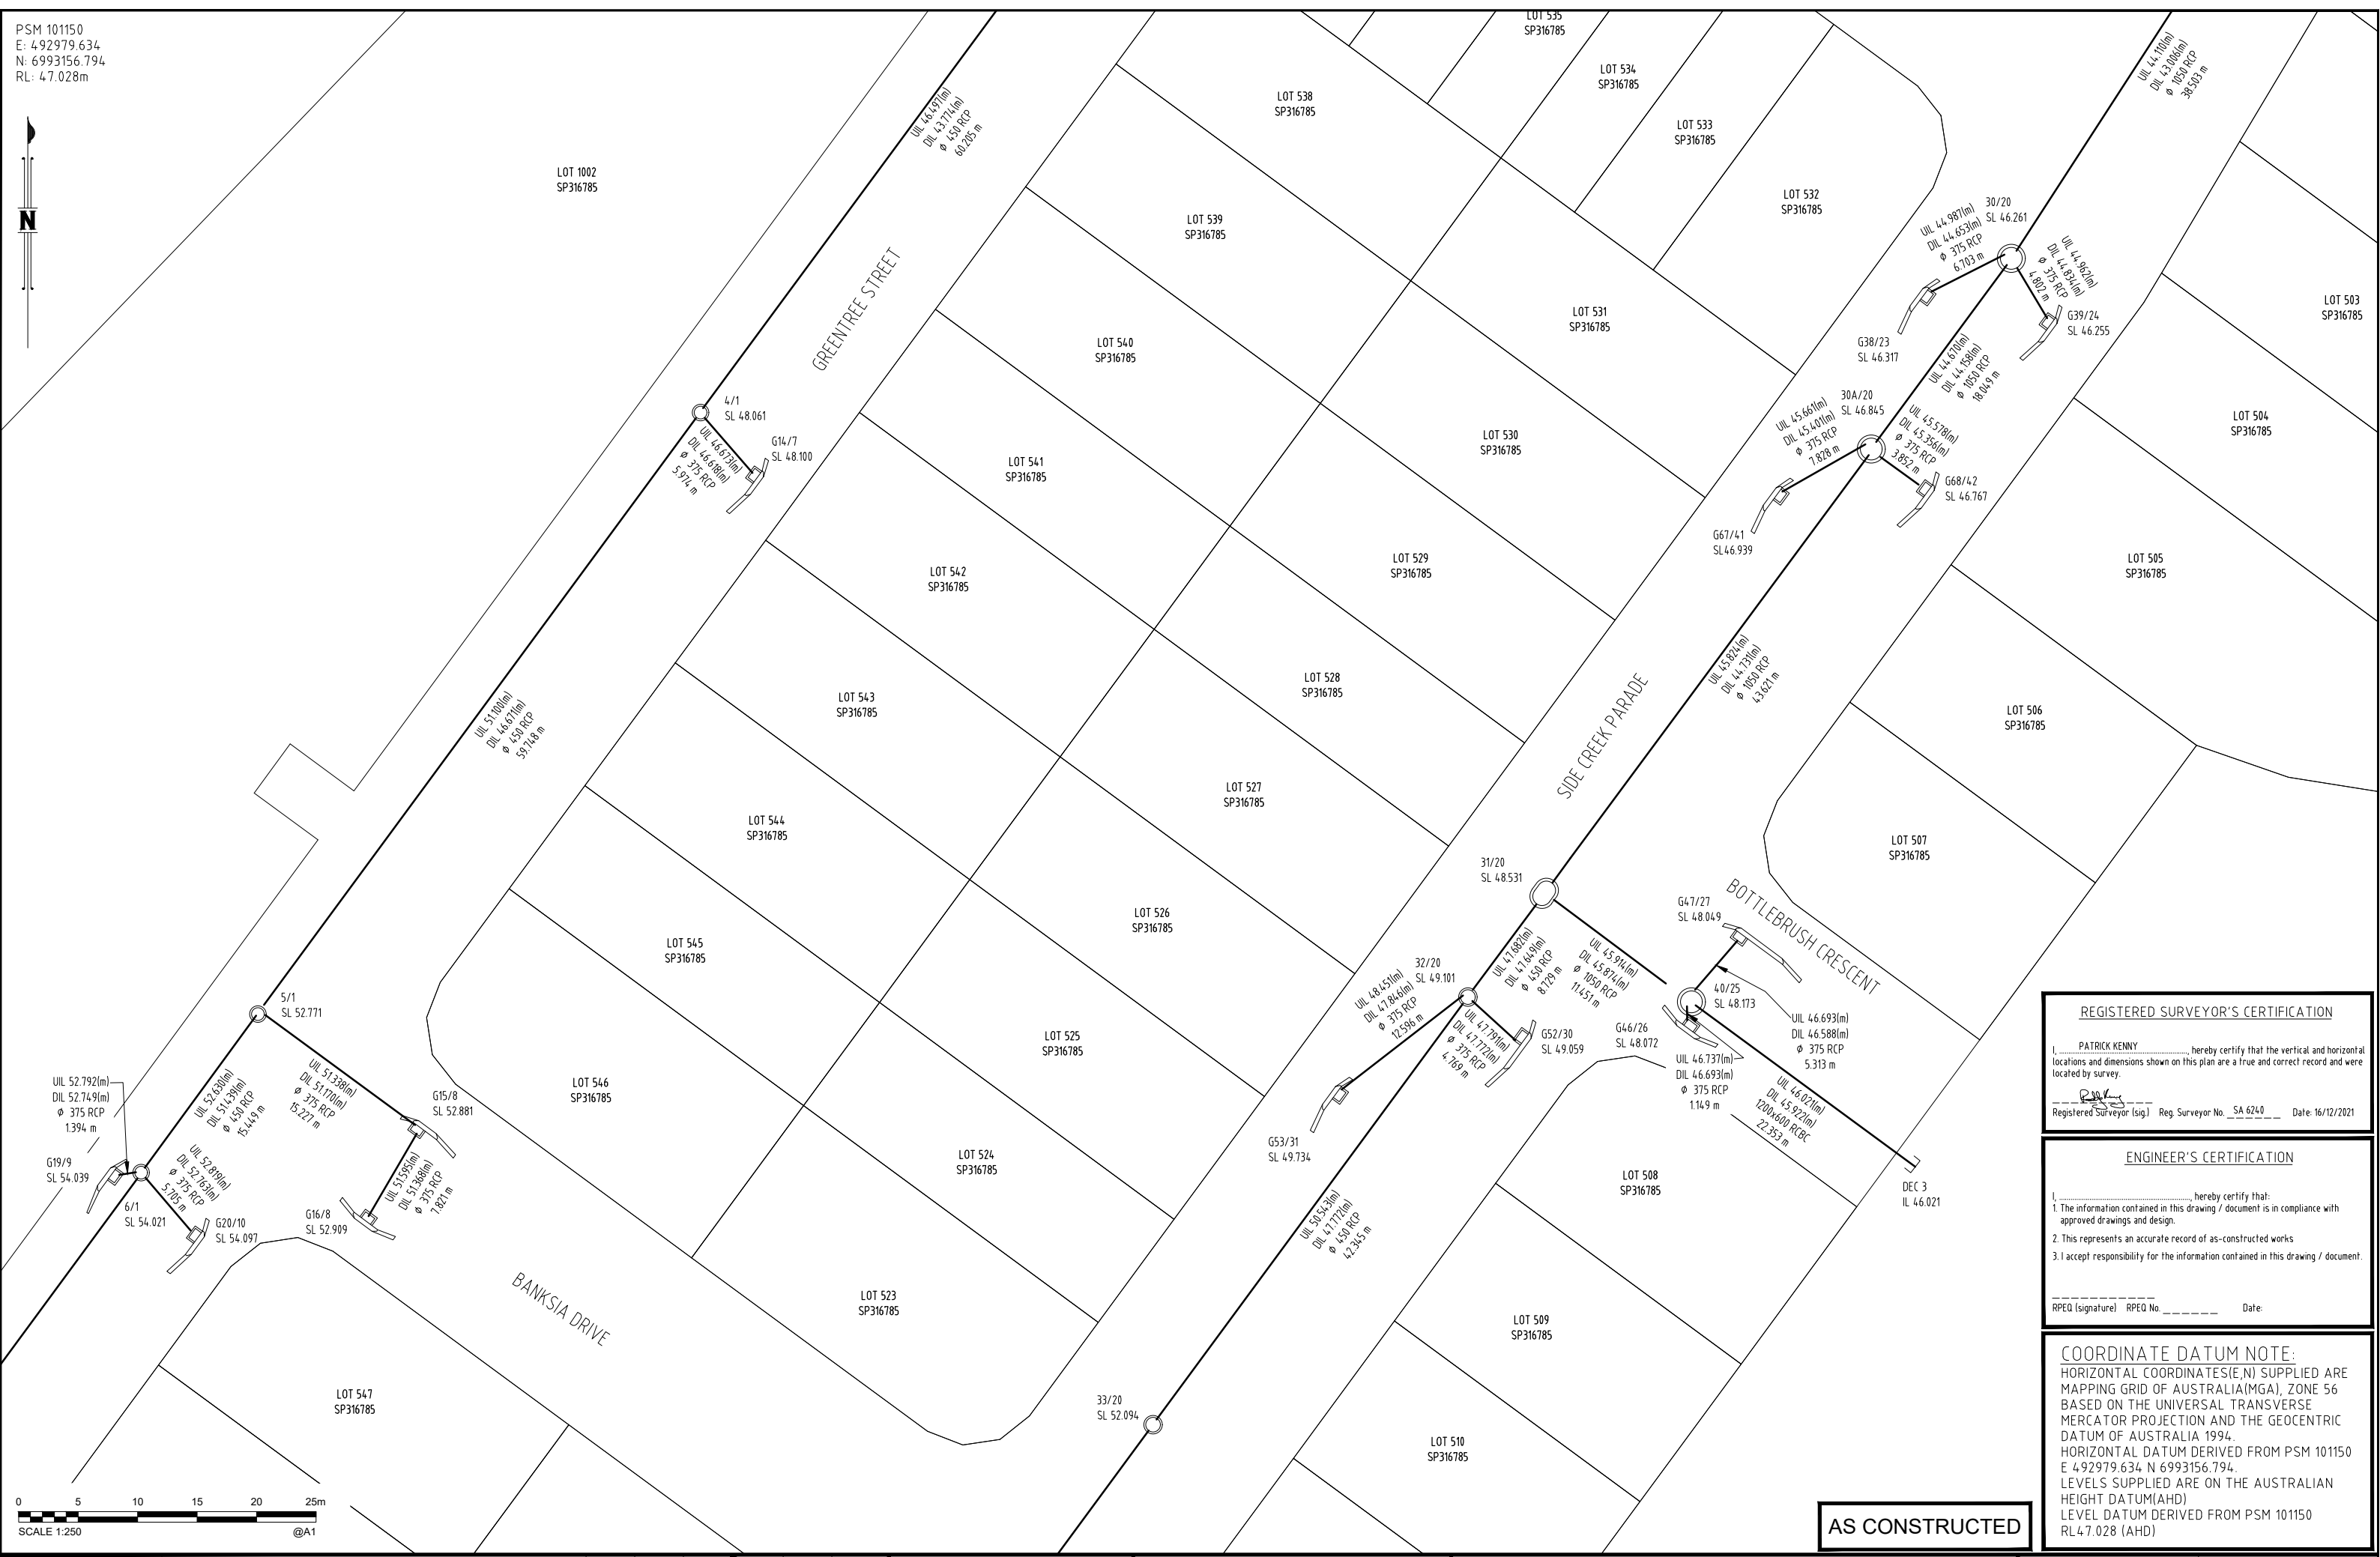

AS CONSTRUCTED

REGISTERED SURVEYOR'S CERTIFICATION
 I, PATRICK KENNY, hereby certify that the vertical and horizontal locations and dimensions shown on this plan are a true and correct record and were located by survey.
 Registered Surveyor (sig.) Reg. Surveyor No. SA 6240 Date: 16/12/2021

ENGINEER'S CERTIFICATION
 I, _____, hereby certify that:
 1. The information contained in this drawing / document is in compliance with approved drawings and design.
 2. This represents an accurate record of as-constructed works
 3. I accept responsibility for the information contained in this drawing / document.
 RPEQ (signature) RPEQ No. _____ Date: _____

COORDINATE DATUM NOTE:
 HORIZONTAL COORDINATES(E,N) SUPPLIED ARE MAPPING GRID OF AUSTRALIA(MGA), ZONE 56 BASED ON THE UNIVERSAL TRANSVERSE MERCATOR PROJECTION AND THE GEOCENTRIC DATUM OF AUSTRALIA 1994.
 HORIZONTAL DATUM DERIVED FROM PSM 101150 E 492979.634 N 6993156.794.
 LEVELS SUPPLIED ARE ON THE AUSTRALIAN HEIGHT DATUM(AHD)
 LEVEL DATUM DERIVED FROM PSM 101150 RL47.028 (AHD)

A1									
	INDEX	DATE	REVISIONS	DRAWN	CHECKED	PASSED	INITIALS	DATE	
	16/12/2021	AS CONSTRUCTED	NJA	DAM	SR			16/12/2021	



DRAWN	NJA	16/12/2021
CHECKED	DAM	16/12/2021
PASSED	SR	16/12/2021



Moreton Bay Regional Council
 DA/36571/2018/V3RL
 AS CONSTRUCTED SURVEY - STORMWATER
 RIDGEVIEW STAGE 5
 NARANGBA QLD

SHEET 3 OF 4 SHEETS	SCALE 1:250
REVISION DATE 16/12/2021	REVISION A
DISCIPLINE CODE	
DRAWING NO.	
ASC0N-STORM-03-2188-5	

PSM 101150
 E: 492979.634
 N: 6993156.794
 RL: 47.028m

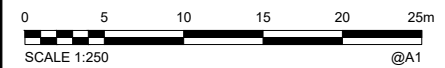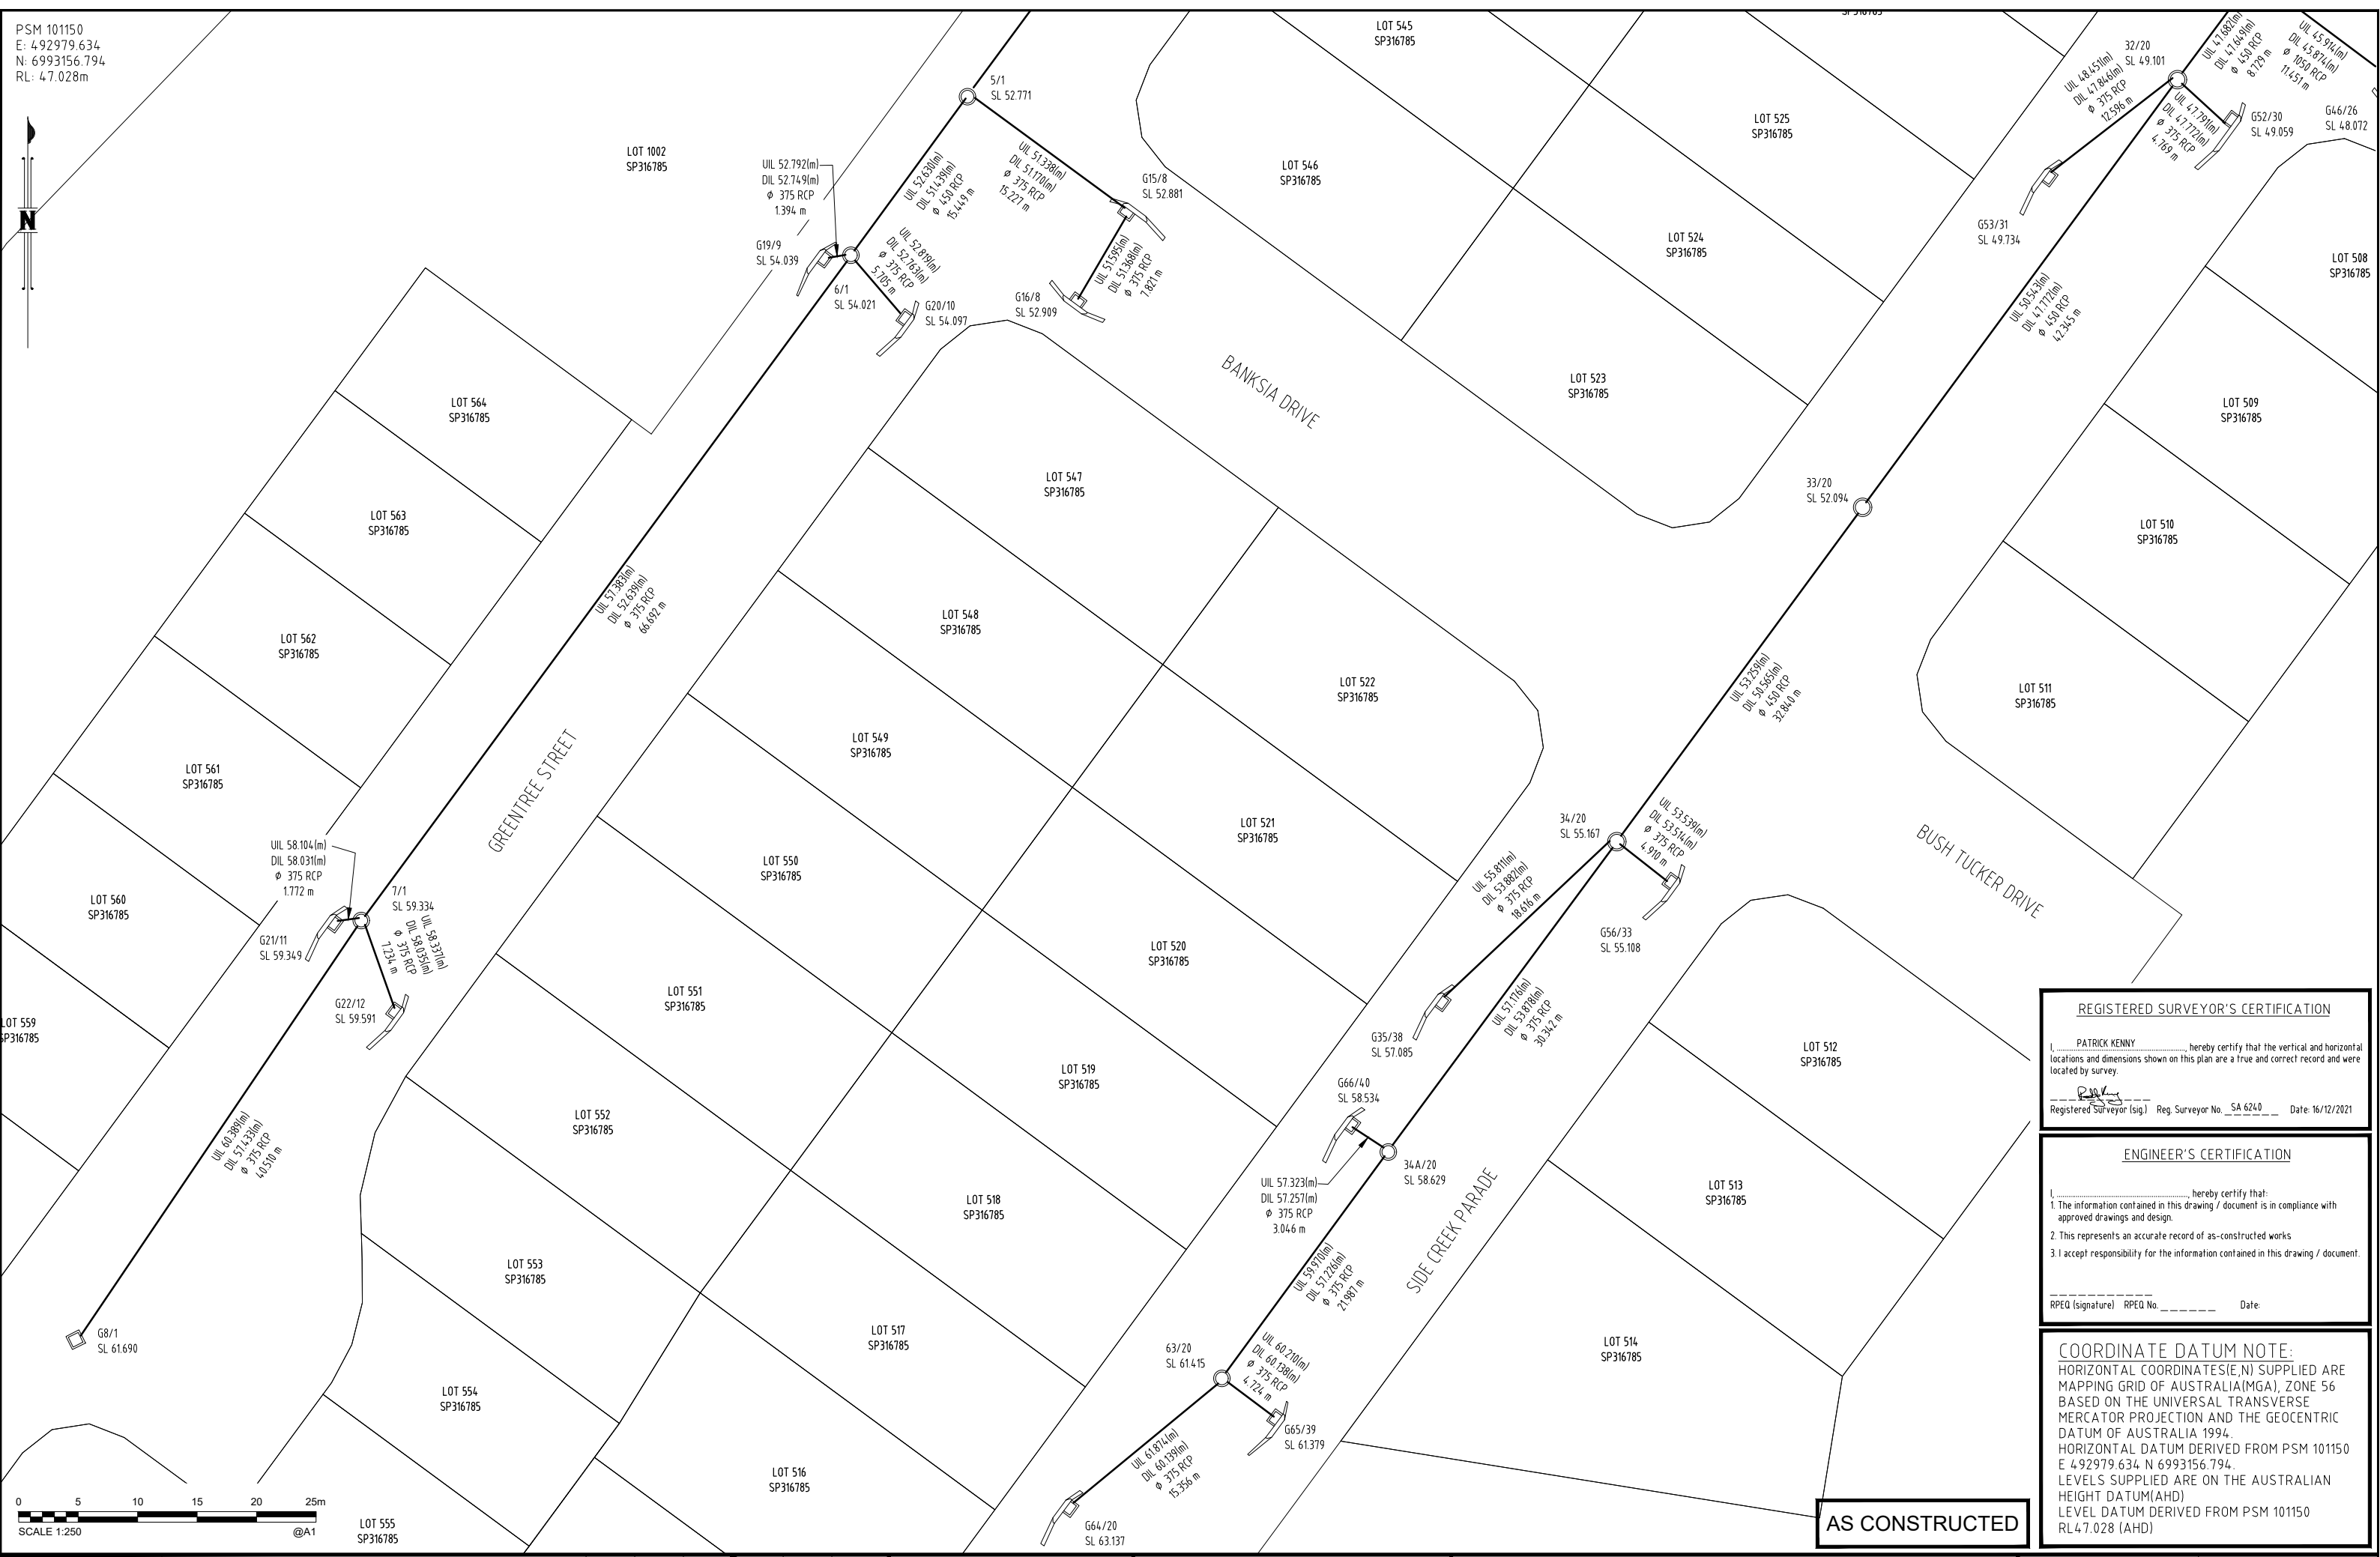

REGISTERED SURVEYOR'S CERTIFICATION
 I, PATRICK KENNY, hereby certify that the vertical and horizontal locations and dimensions shown on this plan are a true and correct record and were located by survey.
 Registered Surveyor (sig.) Reg. Surveyor No. SA 6240 Date: 16/12/2021

ENGINEER'S CERTIFICATION
 I, _____, hereby certify that:
 1. The information contained in this drawing / document is in compliance with approved drawings and design.
 2. This represents an accurate record of as-constructed works
 3. I accept responsibility for the information contained in this drawing / document.
 RPEQ (signature) RPEQ No. _____ Date: _____

COORDINATE DATUM NOTE:
 HORIZONTAL COORDINATES(E,N) SUPPLIED ARE MAPPING GRID OF AUSTRALIA(MGA), ZONE 56 BASED ON THE UNIVERSAL TRANSVERSE MERCATOR PROJECTION AND THE GEOCENTRIC DATUM OF AUSTRALIA 1994.
 HORIZONTAL DATUM DERIVED FROM PSM 101150 E 492979.634 N 6993156.794.
 LEVELS SUPPLIED ARE ON THE AUSTRALIAN HEIGHT DATUM(AHD)
 LEVEL DATUM DERIVED FROM PSM 101150 RL47.028 (AHD)

AS CONSTRUCTED

A1	INDEX	DATE	REVISIONS	DRAWN	CHECKED	PASSED
	A	16/12/2021	AS CONSTRUCTED	NJA	DAM	SR

DRAWN	NJA	16/12/2021
CHECKED	DAM	16/12/2021
PASSED	SR	16/12/2021
INITIALS		DATE



Moreton Bay Regional Council
 DA/36571/2018/V3RL
 AS CONSTRUCTED SURVEY - STORMWATER
 RIDGEVIEW STAGE 5
 NARANGBA QLD

SHEET 4 OF 4 SHEETS	SCALE 1:250
REVISION DATE 16/12/2021	REVISION A
DISCIPLINE CODE	
DRAWING NO.	
ASCN-STORM-04-2188-5	