

PSM 101150
 E: 492979.634
 N: 6993156.794
 RL: 47.028m



COORDINATE DATUM NOTE
 HORIZONTAL COORDINATES(E,N) SUPPLIED ARE
 MAPPING GRID OF AUSTRALIA(MGA), ZONE 56
 BASED ON THE UNIVERSAL TRANSVERSE
 MERCATOR PROJECTION AND THE GEOCENTRIC
 DATUM OF AUSTRALIA 1994.
 HORIZONTAL DATUM DERIVED FROM PSM 101150
 E 492979.634 N 6993156.794.
 LEVELS SUPPLIED ARE ON THE AUSTRALIAN
 HEIGHT DATUM(AHD)
 LEVEL DATUM DERIVED FROM PSM 101150
 RL 47.028 (AHD)

REGISTERED SURVEYOR'S CERTIFICATION
 I, PATRICK KENNY, hereby certify that the vertical and horizontal
 locations and dimensions shown on this plan are a true and correct record and were
 located by survey.
 Registered Surveyor (sig) [Signature] Reg. Surveyor No. SA 6240 Date: 30/06/2022

ENGINEER'S CERTIFICATION
 I, _____, hereby certify that:
 1. The information contained in this drawing / document is in compliance with
 approved drawings and design.
 2. This represents an accurate record of as-constructed works
 3. I accept responsibility for the information contained in this drawing / document.
 RPEQ (signature) _____ RPEQ No. _____ Date: _____



AS CONSTRUCTED


INDEX	DATE	REVISIONS	DRAWN	CHECKED	PASSED	INITIALS	DATE
A1	-	-	-	-	-	-	-
A	30/06/2022	AS CONSTRUCTED	NJA	DAM	SR		30/06/2022



Moreton Bay Regional Council
 DA/36571/2018/V3RL
 AS CONSTRUCTED SURVEY - STORMWATER
 RIDGVIEW STAGE 6 & 7c
 NARANGBA QLD

SHEET 1 OF 3 SHEETS	SCALE 1:1000
REVISION DATE 30/06/2022	REVISION A
DISCIPLINE CODE	
DRAWING NO.	
ASCN-STORM-01-2188-6	

PSM 101150
 E: 492979.634
 N: 6993156.794
 RL: 47.028m

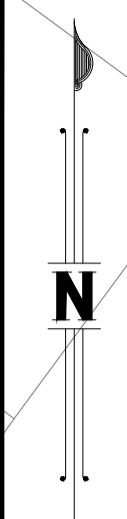

AS CONSTRUCTED

REGISTERED SURVEYOR'S CERTIFICATION
 I, PATRICK KENNY, hereby certify that the vertical and horizontal locations and dimensions shown on this plan are a true and correct record and were located by survey.
 Registered Surveyor (sig) _____ Reg. Surveyor No. SA 6240 Date: 30/06/2022

ENGINEER'S CERTIFICATION
 I, _____, hereby certify that:
 1. The information contained in this drawing / document is in compliance with approved drawings and design.
 2. This represents an accurate record of as-constructed works
 3. I accept responsibility for the information contained in this drawing / document.
 RPEQ (signature) _____ RPEQ No. _____ Date: _____

COORDINATE DATUM NOTE:
 HORIZONTAL COORDINATES(E,N) SUPPLIED ARE MAPPING GRID OF AUSTRALIA(MGA), ZONE 56 BASED ON THE UNIVERSAL TRANSVERSE MERCATOR PROJECTION AND THE GEOCENTRIC DATUM OF AUSTRALIA 1994.
 HORIZONTAL DATUM DERIVED FROM PSM 101150 E 492979.634 N 6993156.794.
 LEVELS SUPPLIED ARE ON THE AUSTRALIAN HEIGHT DATUM(AHD)
 LEVEL DATUM DERIVED FROM PSM 101150 RL47.028 (AHD)



A1	INDEX	DATE	REVISIONS	DRAWN	CHECKED	PASSED	INITIALS	DATE
	-	-	-	-	-	-	-	-
A	30/06/2022	AS CONSTRUCTED		NJA	DAM	SR		30/06/2022

DRAWN	NJA	30/06/2022
CHECKED	DAM	30/06/2022
PASSED	SR	30/06/2022



Moreton Bay Regional Council
 DA/36571/2018/V3RL
 AS CONSTRUCTED SURVEY - STORMWATER
 RIDGEVIEW STAGE 6 & 7c
 NARANGBA QLD

SHEET 3 OF 3 SHEETS	SCALE 1:250
REVISION DATE 30/06/2022	REVISION A
DISCIPLINE CODE	
DRAWING NO.	
ASCN-STORM-03-2188-6	