

PSM 101150
 E: 492979.953
 N: 6993458.441
 RL: 4.7028m



ENGINEER'S CERTIFICATION

I, _____, hereby certify that:
 1. The information contained in this drawing / document is in compliance with approved drawings and design.
 2. The new water and sewerage works defined by this drawing have been designed and constructed in accordance with the SEQ Code.
 3. This represents an accurate record of as-constructed works.
 4. I accept responsibility for the information contained in this drawing / document.


RPEQ (signature) RPEQ No. _____ Date: _____

AS CONSTRUCTED

REGISTERED SURVEYOR'S CERTIFICATION

I, **PATRICK KENNY**, hereby certify that the vertical and horizontal locations and dimensions shown on this plan are a true and correct record and were located by survey.

Patrick Kenny
 Graduate Surveyor (sig) Reg. Surveyor No. 6240 Date: 17/05/2022

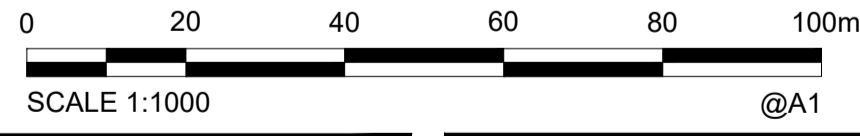

● FHV/DFH	FIRE HYDRANT/ DUCKFOOT HYDRANT
⊕ SV	STOP VALVE
⊕	WATER METER LOT
()	READY TAP
>	FITTING
—	WATER PIPE SIZE AND CLASS AS SHOWN
—	Ø100 PVC-U UPVC CONDUIT

COORDINATE DATUM NOTE:
 HORIZONTAL COORDINATES(E,N) SUPPLIED ARE MAPPING GRID OF AUSTRALIA(MGA), ZONE 56 BASED ON THE UNIVERSAL TRANSVERSE MERCATOR PROJECTION AND THE GEOCENTRIC DATUM OF AUSTRALIA 2020.
 HORIZONTAL DATUM DERIVED FROM PSM 101150 E 492979.953 N 6993458.441
 LEVELS SUPPLIED ARE ON THE AUSTRALIAN HEIGHT DATUM(AHD)
 LEVEL DATUM DERIVED FROM PSM 101150 RL4.7028 (AHD)

NOTES:
 ALL SERVICE CONNECTIONS ARE Ø25 PE 100 PN16

A1

INDEX	DATE	REVISIONS	DRAWN	CHECKED	PASSED
A	17/05/2022	AS CONSTRUCTED	NJA	DAM	AM

DRAWN	INITIALS	DATE
DRAWN	NJA	17/05/2022
CHECKED	DAM	17/05/2022
PASSED	AM	17/05/2022



Unitywater
 201801274856_7C
 AS CONSTRUCTED SURVEY - WATER
 RIDGEVIEW STAGE 5A
 NARANGBA QLD

SHEET 1 OF 3 SHEETS	SCALE 1:1000 A1
REVISION DATE 17/05/2022	REVISION A
DISCIPLINE CODE -	
DRAWING NO. U-2021-3814-S6-W1	

ENGINEER'S CERTIFICATION

I, _____, hereby certify that:
 1. The information contained in this drawing / document is in compliance with approved drawings and design.
 2. The new water and sewerage works defined by this drawing have been designed and constructed in accordance with the SEQ Code.
 3. This represents an accurate record of as-constructed works.
 4. I accept responsibility for the information contained in this drawing / document.

RPEQ (signature) RPEQ No. _____ Date: _____

NOTES:

ALL SERVICE CONNECTIONS ARE $\phi 25$ PE 100 PN16

PSM 101150
 E: 492979.953
 N: 6993458.441
 RL: 47.028m

REGISTERED SURVEYOR'S CERTIFICATION

I, **PATRICK KENNY**, hereby certify that the vertical and horizontal locations and dimensions shown on this plan are a true and correct record and were located by survey.

Graduate Surveyor (sig) Reg. Surveyor No. 6240 Date: 17/05/2022

- FIRE HYDRANT/ DUCKFOOT HYDRANT
- STOP VALVE
- WATER METER LOT
- READY TAP
- FITTING
- WATER PIPE SIZE AND CLASS AS SHOWN
- $\phi 100$ PVC-U UPVC CONDUIT

COORDINATE DATUM NOTE:

HORIZONTAL COORDINATES (E,N) SUPPLIED ARE MAPPING GRID OF AUSTRALIA (MGA), ZONE 56 BASED ON THE UNIVERSAL TRANSVERSE MERCATOR PROJECTION AND THE GEOCENTRIC DATUM OF AUSTRALIA 2020.
 HORIZONTAL DATUM DERIVED FROM PSM 101150 E 492979.953 N 6993458.441
 LEVELS SUPPLIED ARE ON THE AUSTRALIAN HEIGHT DATUM (AHD)
 LEVEL DATUM DERIVED FROM PSM 101150 RL 47.028 (AHD)



AS CONSTRUCTED



A1	INDEX	DATE	REVISIONS	DRAWN	CHECKED	PASSED	INITIALS	DATE		Unitywater 201801274856_7C AS CONSTRUCTED SURVEY - WATER RIDGEVIEW STAGE 6 AND 7C NARANGBA QLD	SHEET 2 OF 3 SHEETS	SCALE 1:250 A1
	A	22/12/2021	AS CONSTRUCTED	NJA	DAM	AM					REVISION A	
											DISCIPLINE CODE -	
											DRAWING NO. U-2021-3814-S6-W2	

