

LEGEND:

- 3.80 LID RL
- AC 4546 ACCESS CHAMBER NUMBER
- ACCESS CHAMBER TYPE
- DROP ACCESS CHAMBER
- TRAFFICABLE COVER
- STANDARD R.C. COVER
- ACCESS CHAMBER NUMBER
- U/S 5.46 UPSTREAM INVERT LEVEL
- 150P/32 PIPE SIZE / GRADE
- 8.0 PIPE LENGTH
- D/S 5.21 DOWNSTREAM INVERT LEVEL
- EXISTING MANHOLE
- CONSTRUCTED MAINS SHOWN
- RUNNING TRAP
- MANHOLE
- CONCRETE ENCASUREMENT
- INSPECTION SHAFT CONNECTION / SLEEVED PIPE
- HOUSE CONNECTION / CONNECTION UNDER RETAINING WALL / BOUNDARY TRAP
- EXISTING MAIN
- INSPECTION SHAFT / INSPECTION OPENING / CAPPED END
- SERVICE LAID IN THIS STAGE FOR RELEASE IN FUTURE STAGE
- SERVICE LAID IN PREVIOUS STAGE TO BE RELEASED IN THIS STAGE
- BENEFICIARY SERVICE LAID IN THIS STAGE

FILE NO.: 136209502
 FTI DATE.: 28/11/2022
 CONTRACTOR: CJ CIVIL SOLUTIONS

LENGTH	PIPE SIZE-TYPE
30m	225P-SN8

NUMBER OF ACCESS CHAMBERS: 0
 NUMBER OF MAINTENANCE SHAFTS: 0
 NUMBER OF LOTS SERVICED: 2

CONSULTING ENGINEERS: **STANTEC** DATE: _____

LICENSED SURVEYORS: **McMULLEN NOLAN GROUP** DATE: _____

As-Constructed values only pertain to the position and inverts of the manholes, IO's and IS's. House Connection information is supplied by others. MNG accept no responsibilities for any inaccuracies of the supplied data.

NOTES:

- ALL MAINS LAID ON A 3.5m ALIGNMENT (U.O.N.).
- FOR CONNECTIONS MADE BY THE WATER CORPORATION REFER TO PLAN NY81-203-001-01B.
- ALL DISTANCES AND LEVELS ARE IN METRES, PIPE DIAMETERS ARE IN MILLIMETRES.
- HEIGHTS ARE BASED ON A.H.D.

CLIENT: SATTERLEY PROPERTY GROUP

PROJECT: DALYELLUP BEACH ESTATE STAGE DC5

TITLE: SEWER RETICULATION PLAN - AS CONSTRUCTED

SHIRE OF CAPEL

RETICULATION AREA: N/A




STANTEC CONSULTING ENGINEERS

W.A.P.C. No. 161451 Date NOV 2022

19190 - AS - 1322 - B

WATER CORPORATION PLAN: NY81-207-001-01A

Rev.	Description	Drawn	Date	Checked
B	FTI & Signature Added	SAH	30/11/2022	CPO
A	Initial Issue	SAH	28/11/2022	CPO

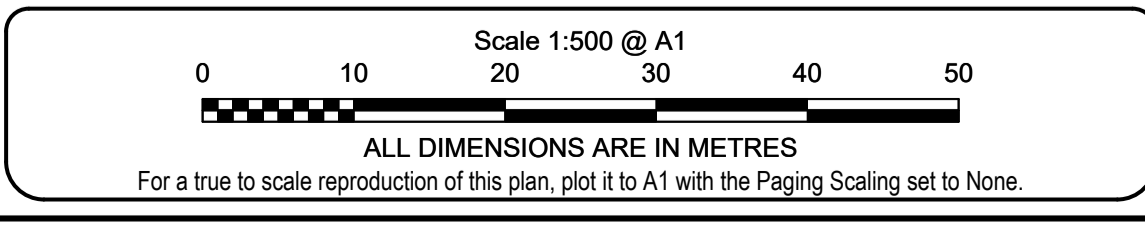

FILES

File S5DC_CONS

Drawing 91900AS-1322B

Cad. File 91900LOTS-9999BU_PCG

Date 13/10/2022



MCMULLEN NOLAN GROUP

Level 1, 2 Sabre Crescent
 Jandakot, W.A. 6164
 PO Box 3526, Success
 W.A. 6964, Australia
 Offices in: Perth | Melbourne | Kimberley | South West WA

Tel: (08) 6436 1599
 Fax: (08) 6436 1500
 info@mngsurvey.com.au
 www.mngsurvey.com.au
 ABN 90 009 363 311