


UNITYWATER PROJECT NUMBER 2018012748S11

RIDGEVIEW - STAGE 8

SEWER AND WATER

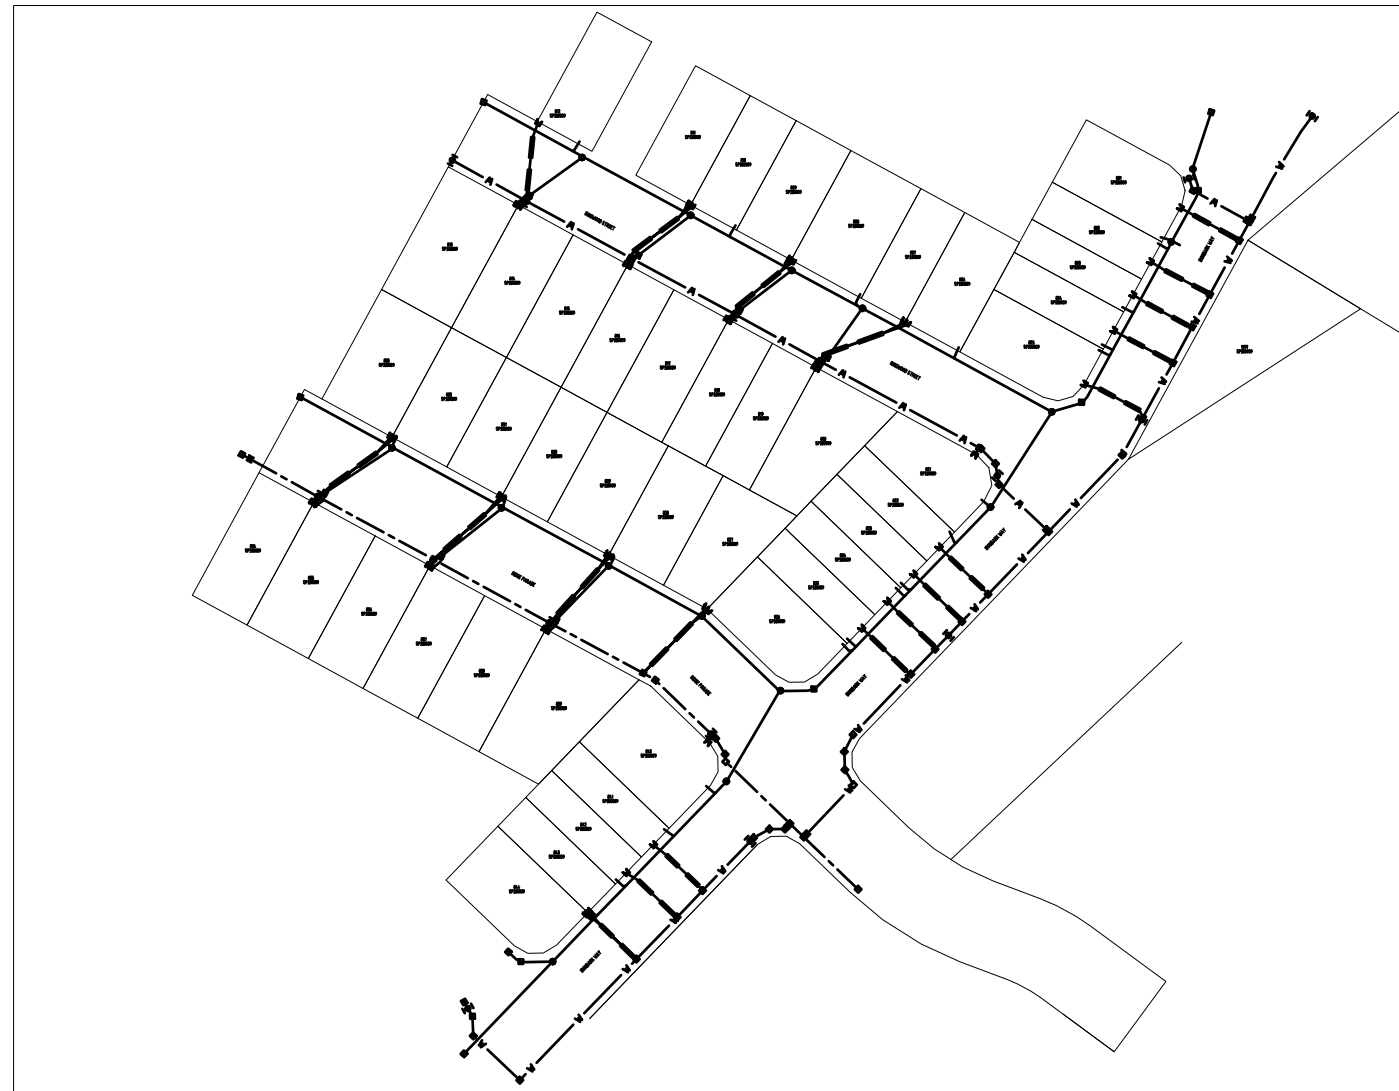

DRAWING INDEX	
DRAWING NUMBER	DESCRIPTION
U-2022-4385-1	LOCALITY PLAN AND DRAWING INDEX
U-2022-4385-2	WATER PLAN - SHEET 1
U-2022-4385-3	WATER PLAN - SHEET 2
U-2022-4385-4	SEWER PLAN - SHEET 1
U-2022-4385-5	SEWER PLAN - SHEET 2

COORDINATE DATUM NOTE:
 HORIZONTAL COORDINATES(E,N) SUPPLIED ARE MAPPING GRID OF AUSTRALIA(MGA), ZONE 56 BASED ON THE UNIVERSAL TRANSVERSE MERCATOR PROJECTION AND THE GEOCENTRIC DATUM OF AUSTRALIA 1994.

ENGINEER'S CERTIFICATION

I, _____, hereby certify that:

1. The information contained in this drawing / document is in compliance with approved drawings and design.
2. The new water and sewerage works defined by this drawing have been designed and constructed in accordance with the SEQ Code.
3. This represents an accurate record of as-constructed works
4. I accept responsibility for the information contained in this drawing / document.

 RPEQ (signature) RPEQ No. _____ Date: _____

REGISTERED SURVEYOR'S CERTIFICATION

I, _____, hereby certify that the vertical and horizontal locations and dimensions shown on this plan are a true and correct record and were located by survey.

 Registered Surveyor (sig) Reg. Surveyor No. _____ Date: _____



AS CONSTRUCTED

A1											
	0	05/06/2023	AS CONSTRUCTED DETAILS	LG	BS	PASSED					
INDEX	DATE	REVISIONS	DRAWN	CHECKED	PASSED		INITIALS	DATE			


LEVEL 2, 1 INNOVATION
 PARKWAY, BIRTNYA, QLD, 4575
 0754435300



Unitywater

2018012748S11
 RIDGEVIEW - STAGE 8
 AS CONSTRUCTED
 SEWER & WATER

SHEET 1 OF 5 SHEETS	SCALE 1:250
REVISION DATE 05/06/2023	REVISION 0
DISCIPLINE CODE C	
DRAWING NO. U-2022-4385-1	

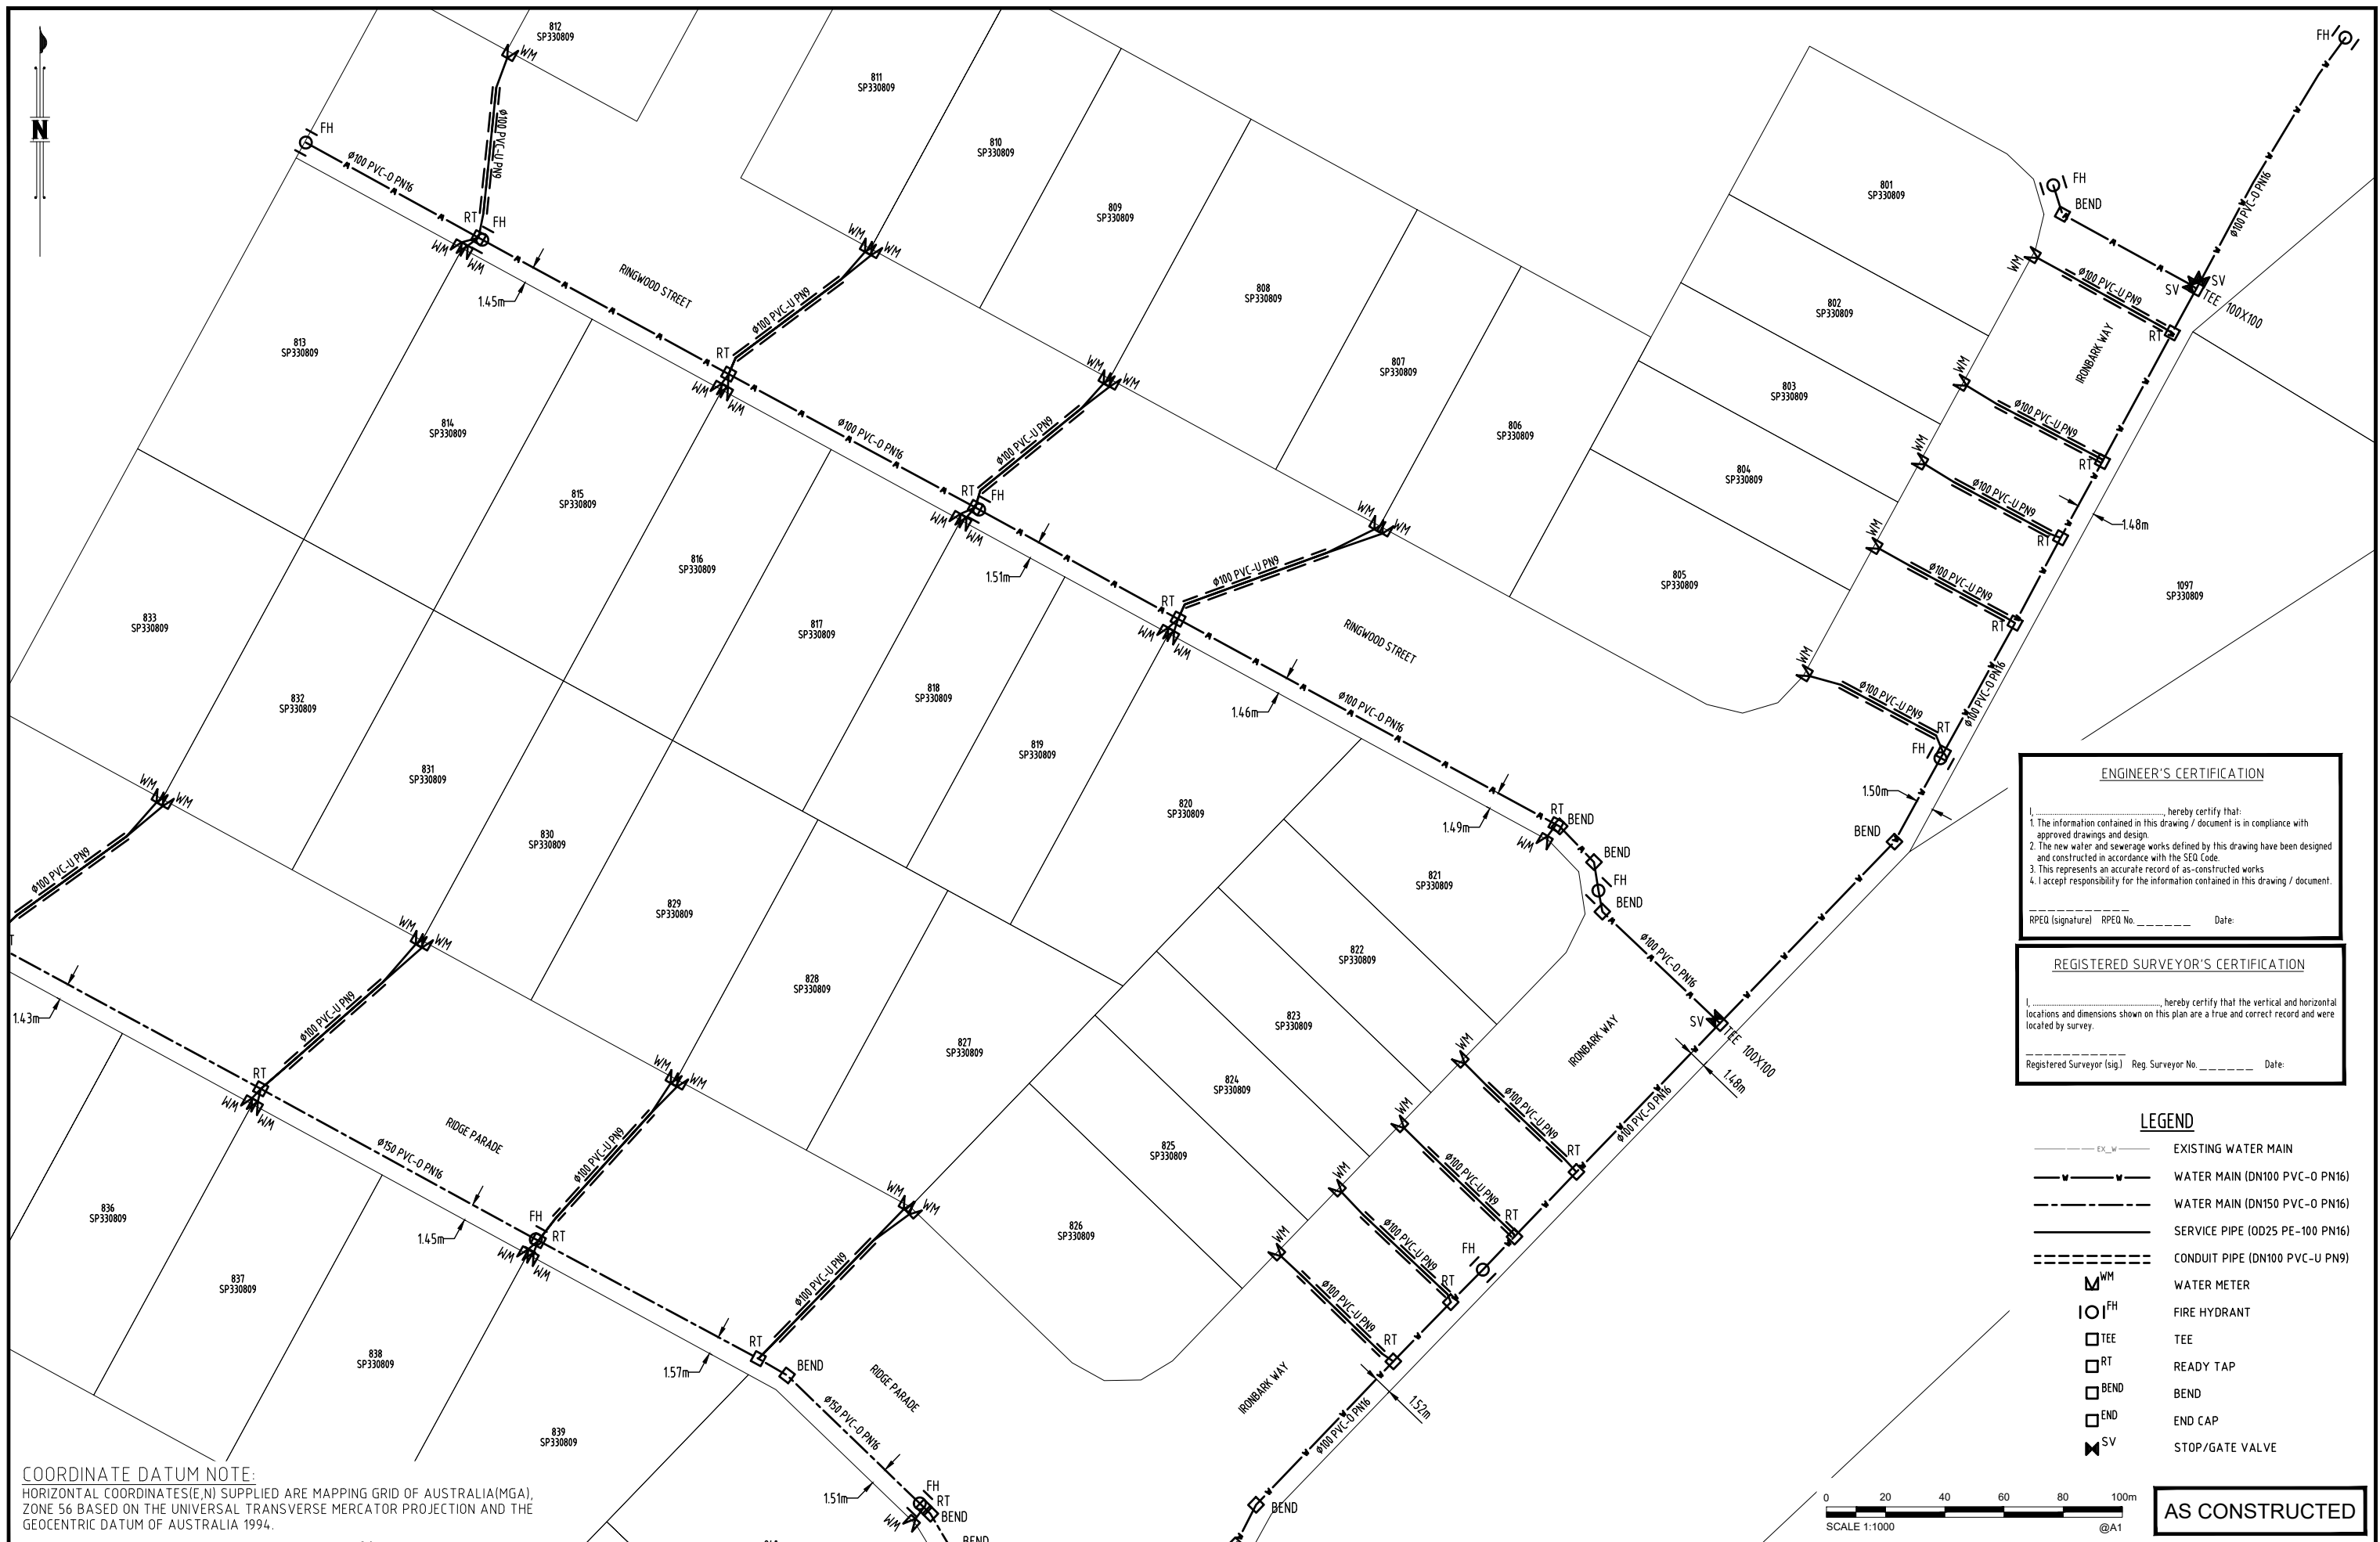

ENGINEER'S CERTIFICATION

I, _____, hereby certify that:

- The information contained in this drawing / document is in compliance with approved drawings and design.
- The new water and sewerage works defined by this drawing have been designed and constructed in accordance with the SEQ Code.
- This represents an accurate record of as-constructed works.
- I accept responsibility for the information contained in this drawing / document.

RPEQ (signature) RPEQ No. _____ Date: _____

REGISTERED SURVEYOR'S CERTIFICATION


I, _____, hereby certify that the vertical and horizontal locations and dimensions shown on this plan are a true and correct record and were located by survey.

Registered Surveyor (sig.) Reg. Surveyor No. _____ Date: _____

LEGEND

	EXISTING WATER MAIN
	WATER MAIN (DN100 PVC-O PN16)
	WATER MAIN (DN150 PVC-O PN16)
	SERVICE PIPE (OD25 PE-100 PN16)
	CONDUIT PIPE (DN100 PVC-U PN9)
	WATER METER
	FIRE HYDRANT
	TEE
	READY TAP
	BEND
	END CAP
	STOP/GATE VALVE

COORDINATE DATUM NOTE:
 HORIZONTAL COORDINATES(E,N) SUPPLIED ARE MAPPING GRID OF AUSTRALIA(MGA), ZONE 56 BASED ON THE UNIVERSAL TRANSVERSE MERCATOR PROJECTION AND THE GEOCENTRIC DATUM OF AUSTRALIA 1994.

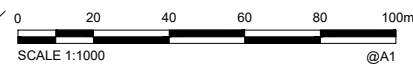

AS CONSTRUCTED

A1	0	05/06/2023	AS CONSTRUCTED DETAILS	LG	BS	
	INDEX	DATE	REVISIONS	DRAWN	CHECKED	PASSED

DRAWN	LG	05/06/2023
CHECKED	BS	05/06/2023
PASSED		
INITIALS	DATE	




LEVEL 2, 1 INNOVATION PARKWAY, BIRTTNYA, QLD, 4575
 0754.135300



Unitywater

2018012748511
 RIDGEVIEW - STAGE 8
 AS CONSTRUCTED
 WATER SUPPLY

SHEET 2 OF 5 SHEETS	SCALE 1:250
REVISION DATE 05/06/2023	REVISION 0
DISCIPLINE CODE C	
DRAWING NO. U-2022-4385-2	

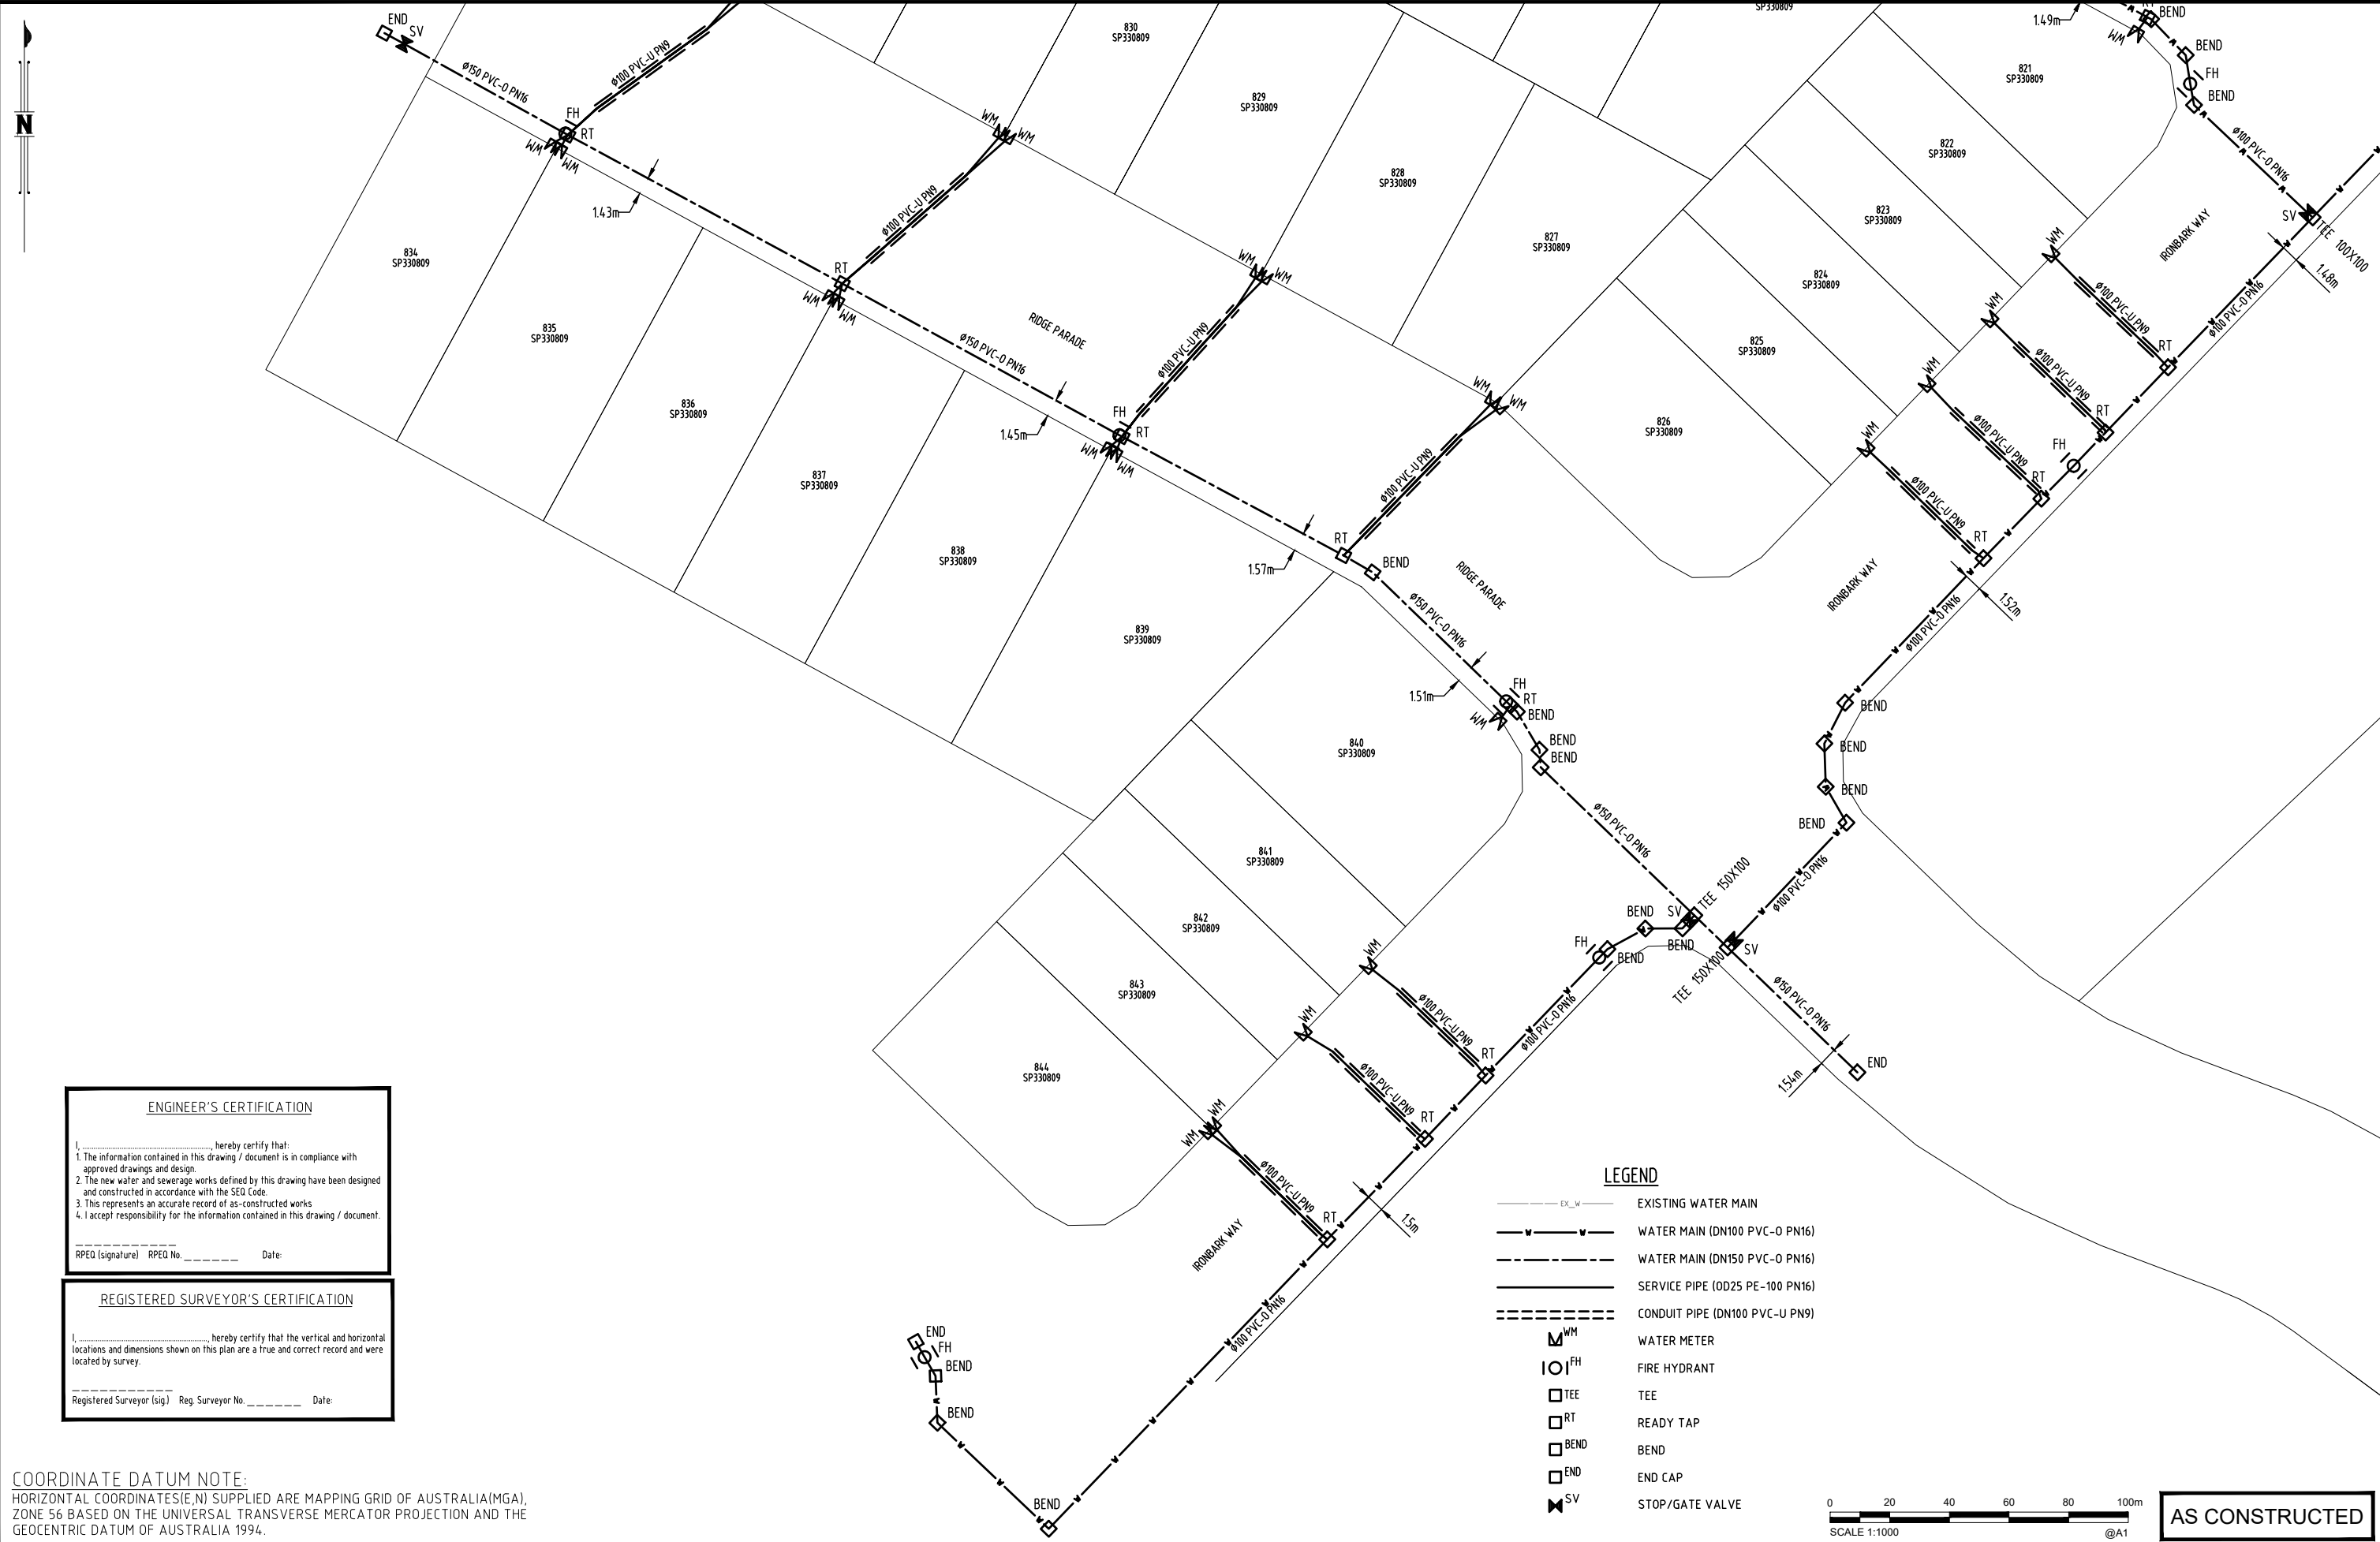

ENGINEER'S CERTIFICATION

I, _____, hereby certify that:

- The information contained in this drawing / document is in compliance with approved drawings and design.
- The new water and sewerage works defined by this drawing have been designed and constructed in accordance with the SEQ Code.
- This represents an accurate record of as-constructed works.
- I accept responsibility for the information contained in this drawing / document.


RPEQ (signature) RPEQ No. _____ Date: _____

REGISTERED SURVEYOR'S CERTIFICATION

I, _____, hereby certify that the vertical and horizontal locations and dimensions shown on this plan are a true and correct record and were located by survey.

Registered Surveyor (sig) Reg. Surveyor No. _____ Date: _____

- LEGEND**
- EX_W — EXISTING WATER MAIN
 - WATER MAIN (DN100 PVC-O PN16)
 - WATER MAIN (DN150 PVC-O PN16)
 - SERVICE PIPE (OD25 PE-100 PN16)
 - CONDUIT PIPE (DN100 PVC-U PN9)
 - WM WATER METER
 - FH FIRE HYDRANT
 - TEE TEE
 - RT READY TAP
 - BEND BEND
 - END END CAP
 - SV STOP/GATE VALVE

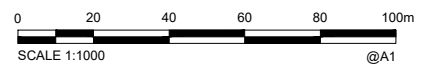

AS CONSTRUCTED

COORDINATE DATUM NOTE:
 HORIZONTAL COORDINATES(E,N) SUPPLIED ARE MAPPING GRID OF AUSTRALIA(MGA), ZONE 56 BASED ON THE UNIVERSAL TRANSVERSE MERCATOR PROJECTION AND THE GEOCENTRIC DATUM OF AUSTRALIA 1994.

A1	0	05/06/2023	AS CONSTRUCTED DETAILS	LG	BS	
	INDEX	DATE	REVISIONS	DRAWN	CHECKED	PASSED

DRAWN	LG	05/06/2023
CHECKED	BS	05/06/2023
PASSED		
INITIALS	DATE	



LEVEL 2, 1 INNOVATION PARKWAY, BIRTNIA, QLD, 4575
 0754.135300



Unitywater

2018012748511
 RIDGEVIEW - STAGE 8
 AS CONSTRUCTED
 WATER SUPPLY

SHEET 3 OF 5 SHEETS	SCALE 1:250
REVISION DATE 05/06/2023	REVISION 0
DISCIPLINE CODE C	
DRAWING NO. U-2022-4385-3	

ENGINEER'S CERTIFICATION


I, _____, hereby certify that:
 1. The information contained in this drawing / document is in compliance with approved drawings and design.
 2. The new water and sewerage works defined by this drawing have been designed and constructed in accordance with the SED Code.
 3. This represents an accurate record of as-constructed works.
 4. I accept responsibility for the information contained in this drawing / document.

RPEQ (signature) RPEQ No. _____ Date: _____

REGISTERED SURVEYOR'S CERTIFICATION


I, _____, hereby certify that the vertical and horizontal locations and dimensions shown on this plan are a true and correct record and were located by survey.

Registered Surveyor (sig) Reg. Surveyor No. _____ Date: _____

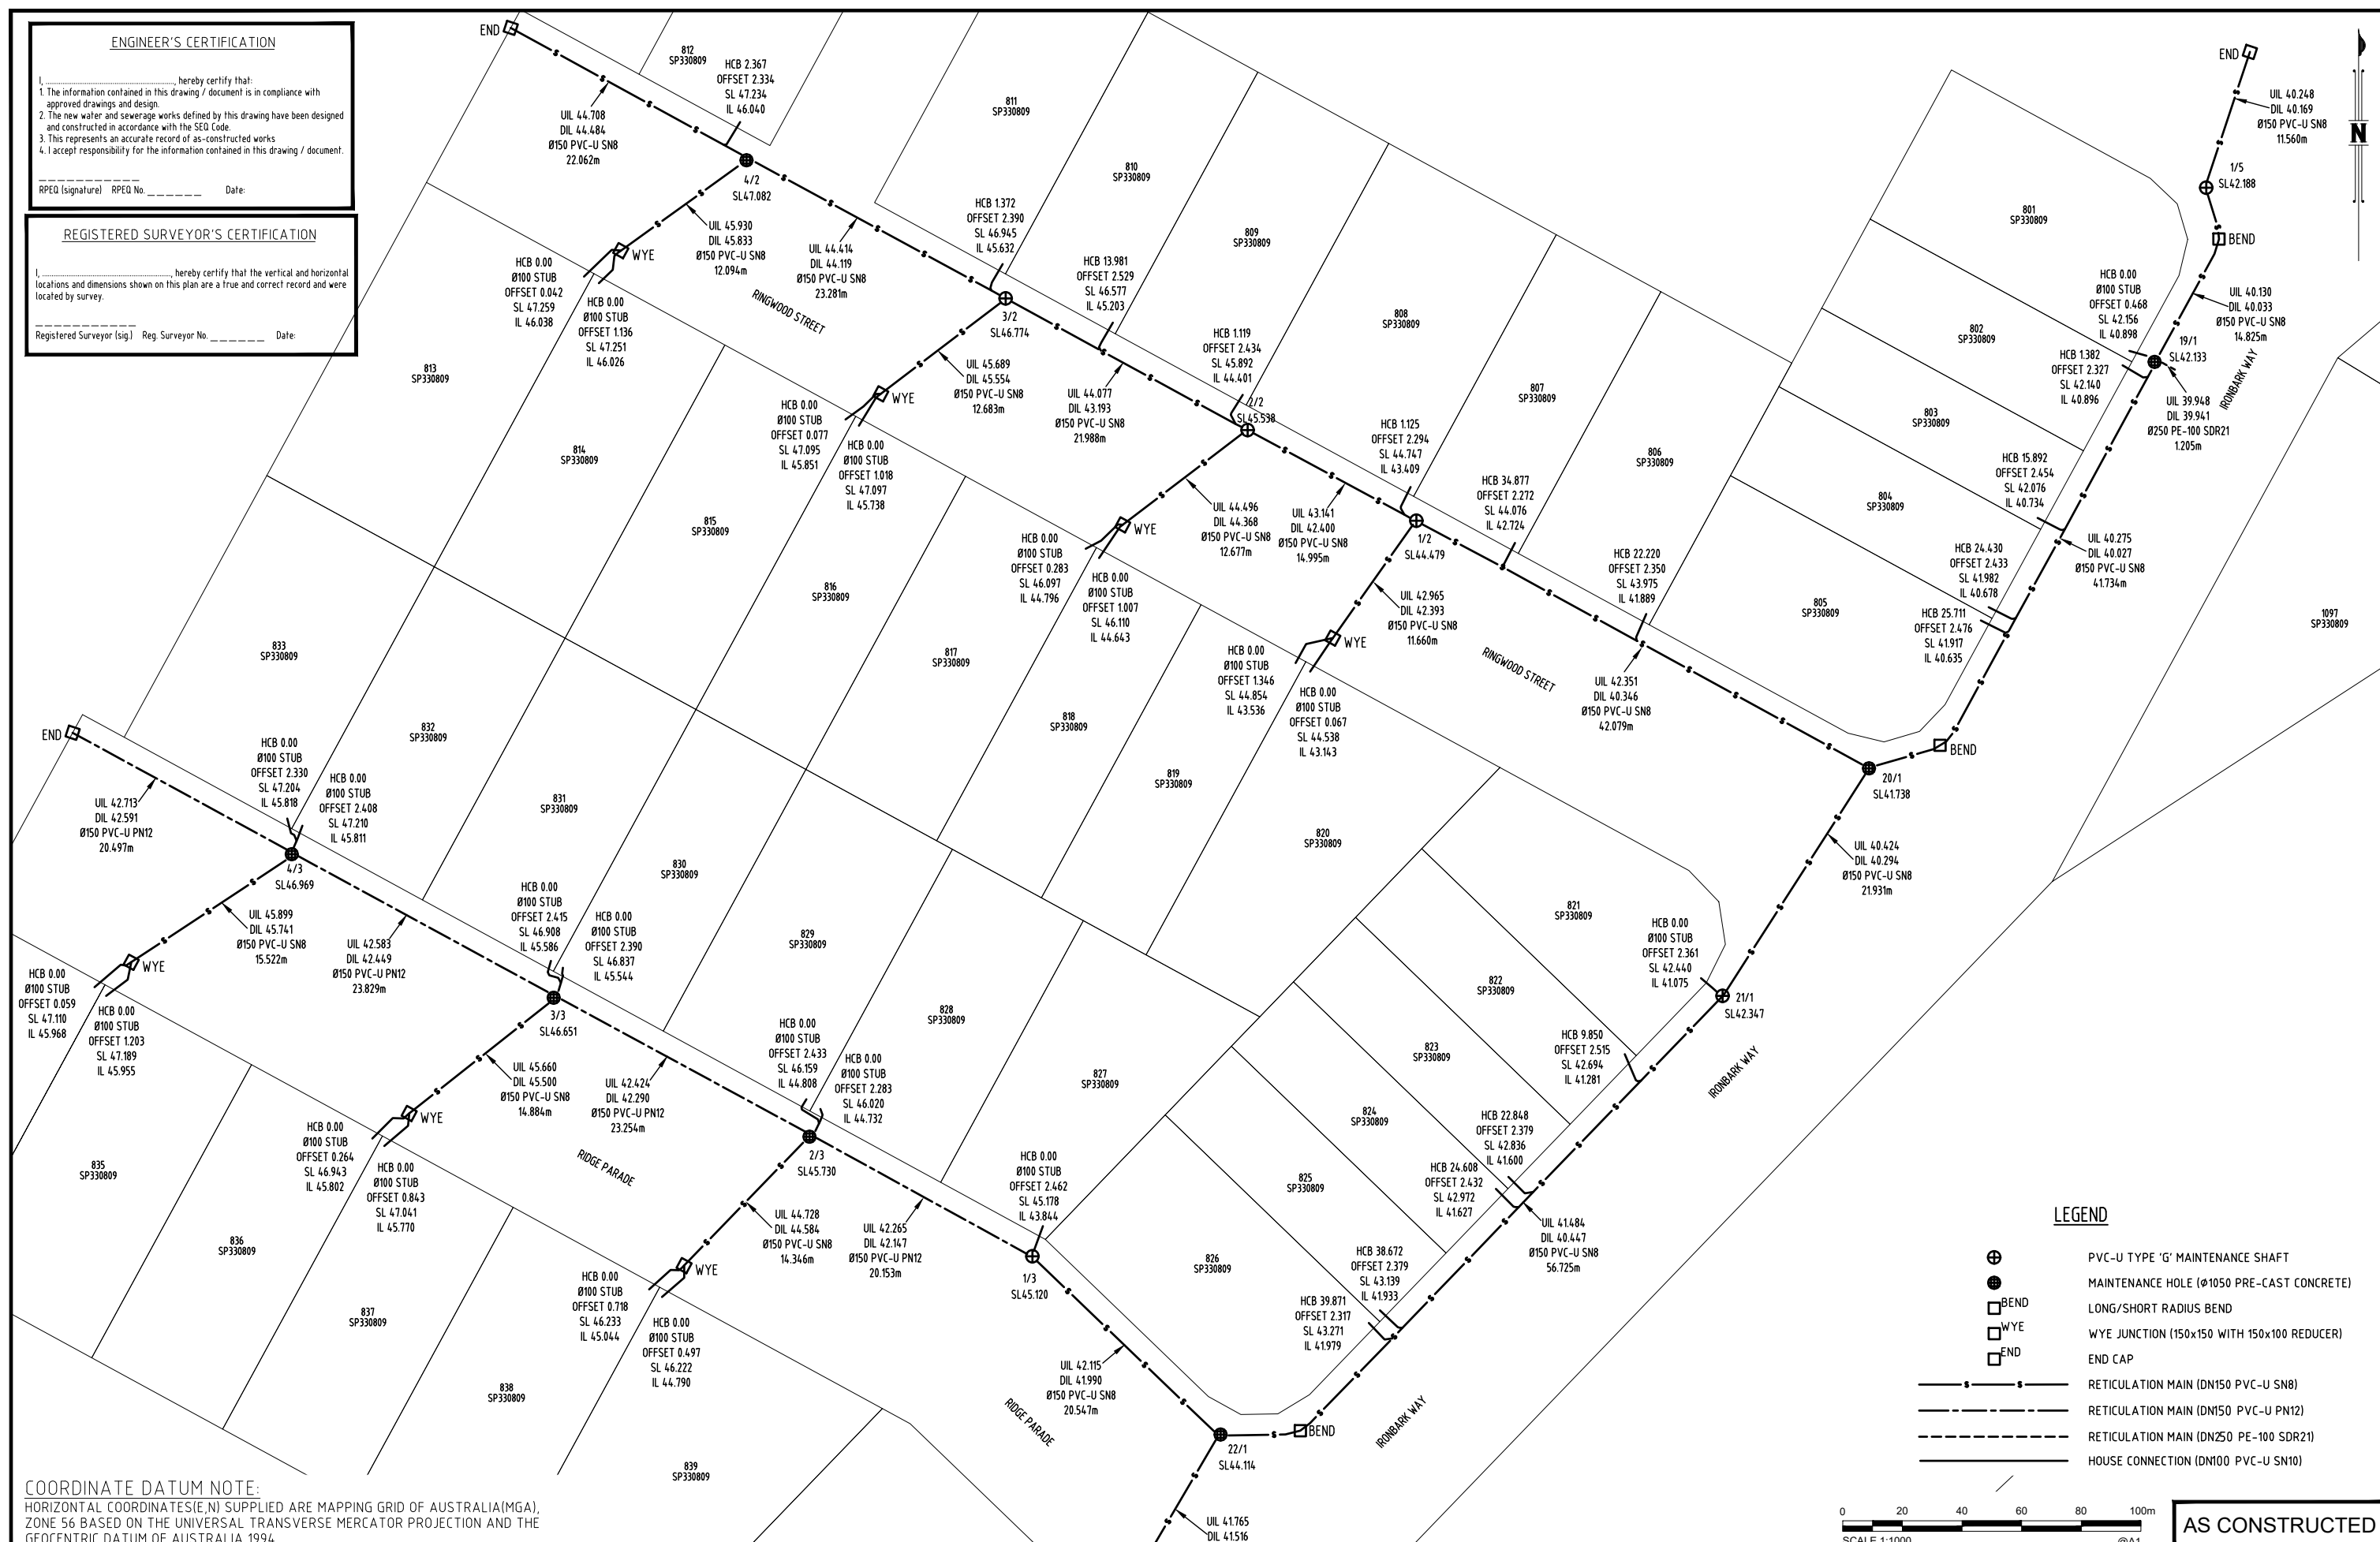

LEGEND

- PVC-U TYPE 'G' MAINTENANCE SHAFT
- MAINTENANCE HOLE (Ø1050 PRE-CAST CONCRETE)
- LONG/SHORT RADIUS BEND
- WYE JUNCTION (150x150 WITH 150x100 REDUCER)
- END CAP
- RETICULATION MAIN (DN150 PVC-U SN8)
- RETICULATION MAIN (DN150 PVC-U PN12)
- RETICULATION MAIN (DN250 PE-100 SDR21)
- HOUSE CONNECTION (DN100 PVC-U SN10)

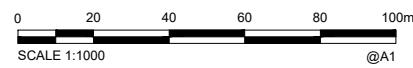

AS CONSTRUCTED

COORDINATE DATUM NOTE:
 HORIZONTAL COORDINATES(E,N) SUPPLIED ARE MAPPING GRID OF AUSTRALIA(MGA), ZONE 56 BASED ON THE UNIVERSAL TRANSVERSE MERCATOR PROJECTION AND THE GEOCENTRIC DATUM OF AUSTRALIA 1994.

A1	0	05/06/2023	AS CONSTRUCTED DETAILS	LG	BS	
	INDEX	DATE	REVISIONS	DRAWN	CHECKED	PASSED

DRAWN	LG	05/06/2023
CHECKED	BS	05/06/2023
PASSED		
INITIALS	DATE	




LEVEL 2, 1 INNOVATION PARKWAY, BIRTMVA, QLD, 4575 0754.135300



Unitywater

2018012748511
 RIDGEVIEW - STAGE 8
 AS CONSTRUCTED
 SEWER RETICULATION

SHEET 4 OF 5 SHEETS	SCALE 1:250
REVISION DATE 05/06/2023	REVISION 0
DISCIPLINE CODE C	
DRAWING NO. U-2022-4385-4	

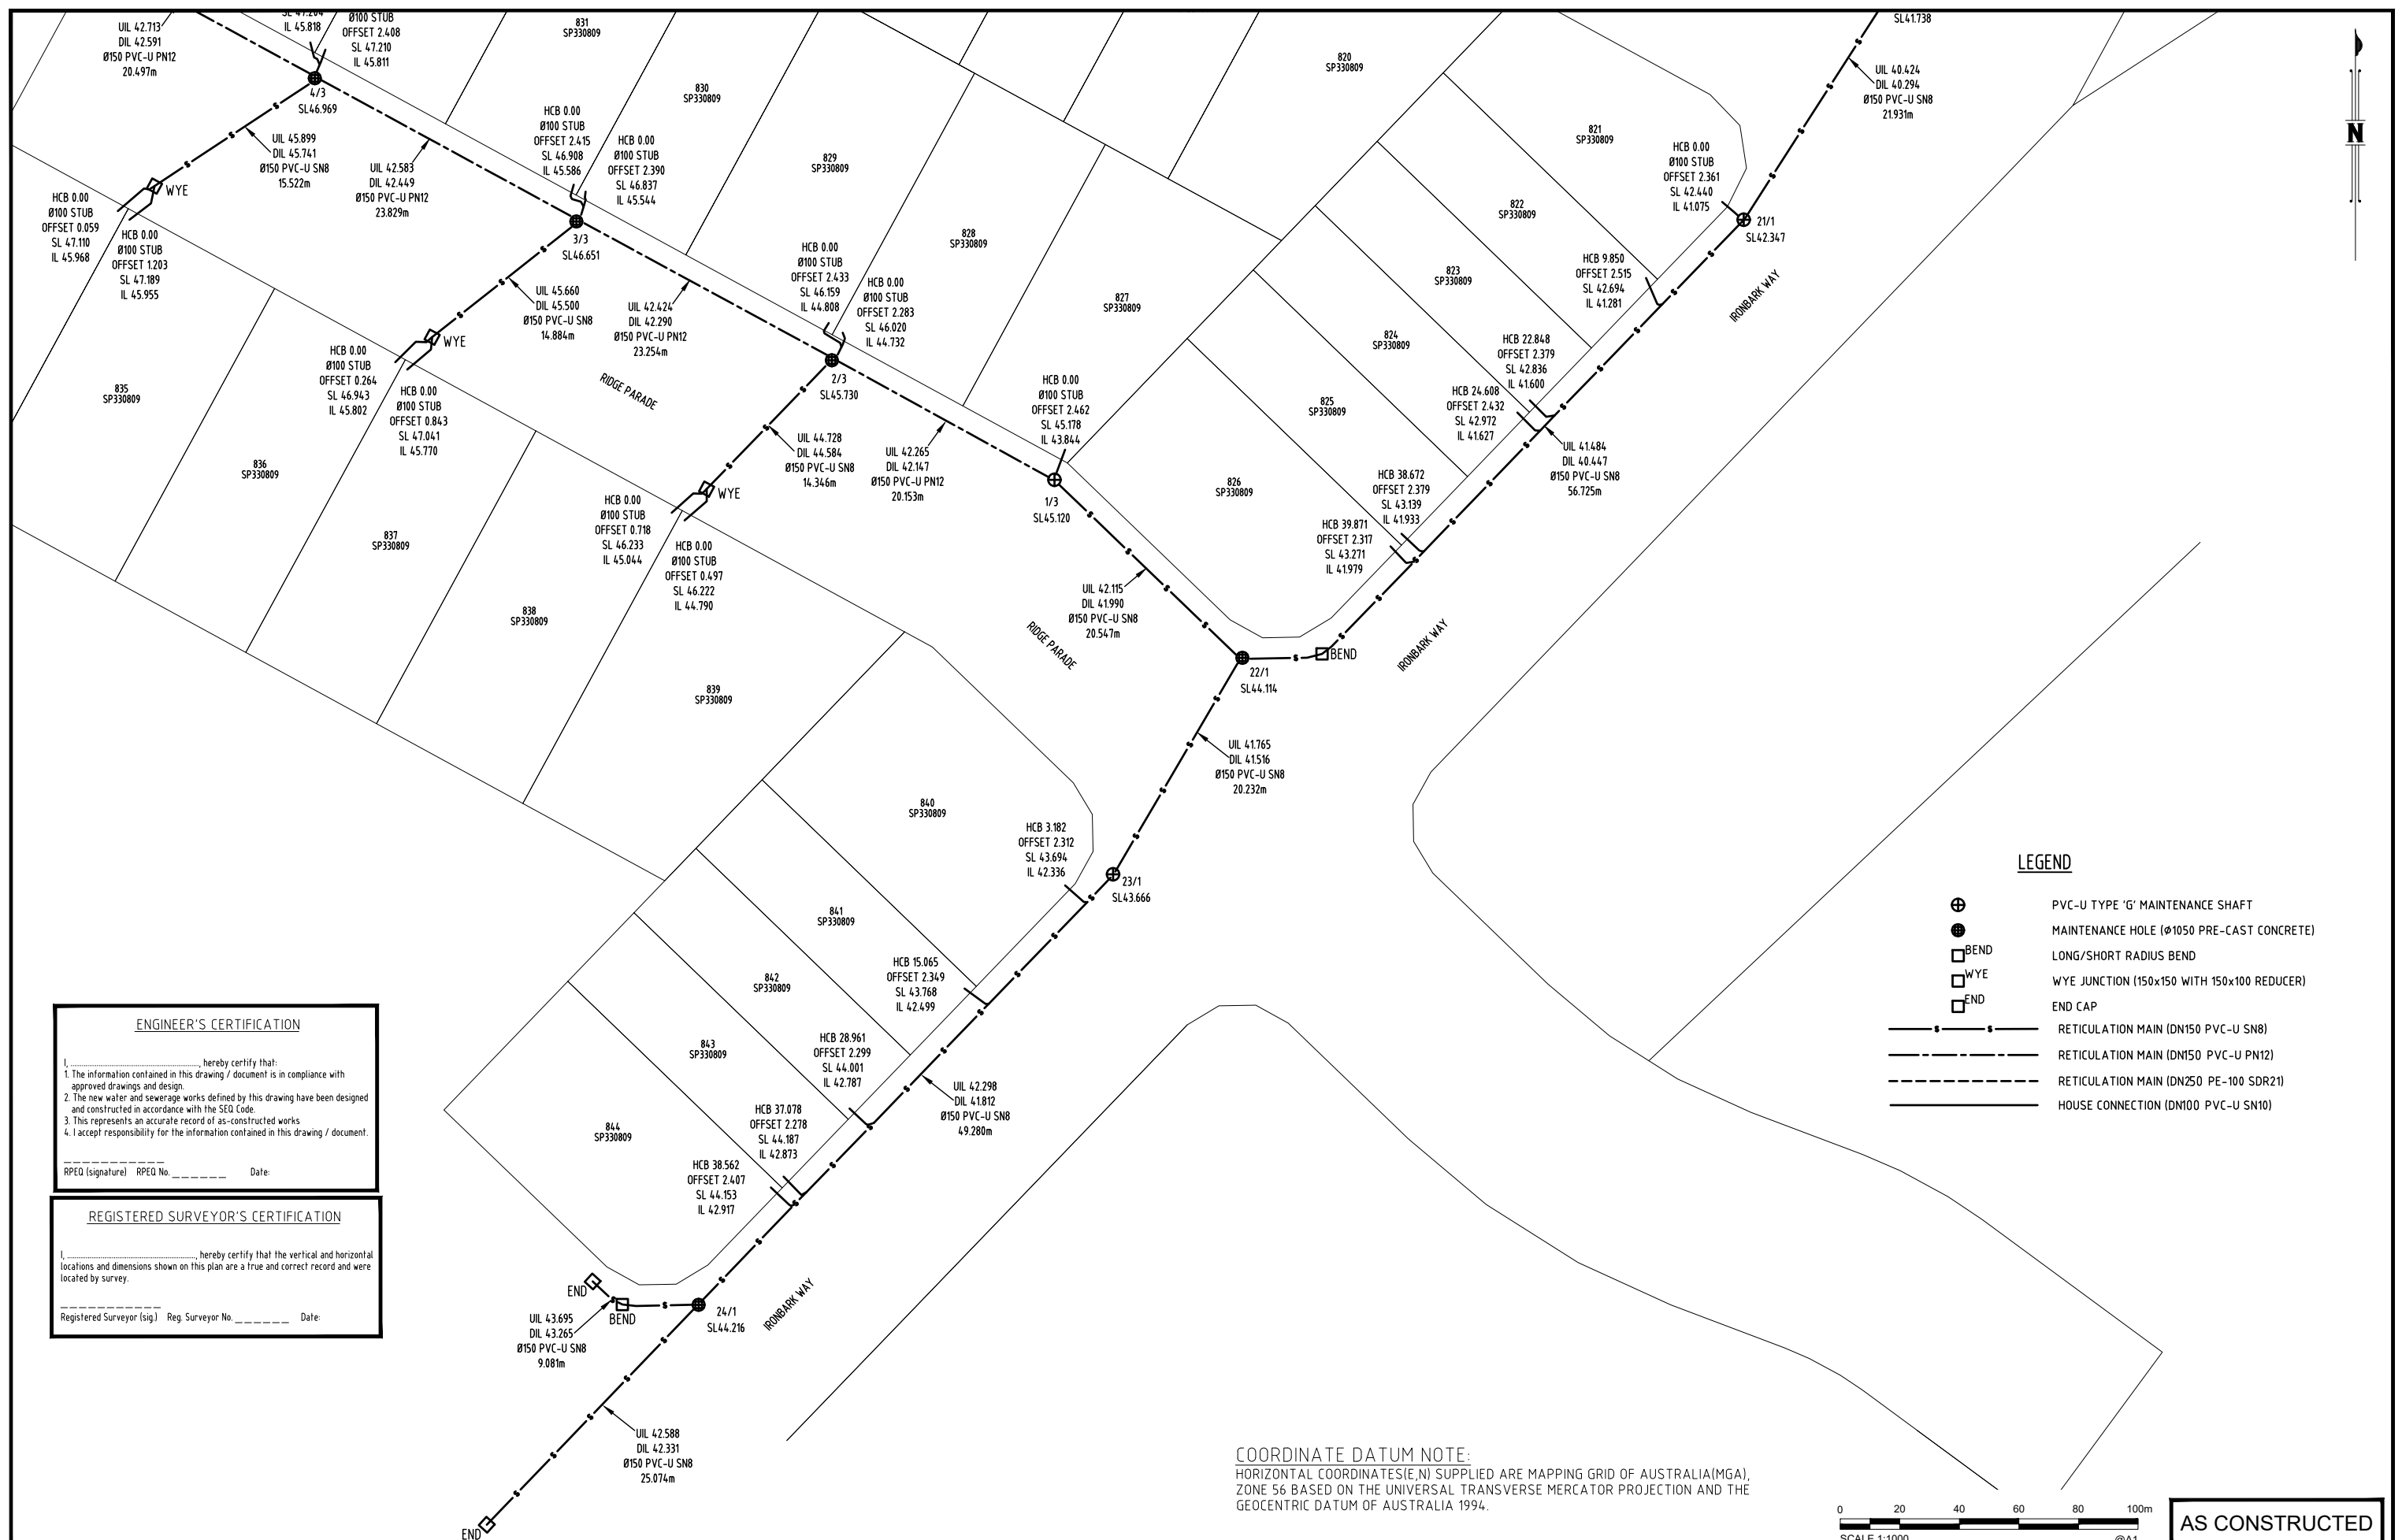

ENGINEER'S CERTIFICATION

I, _____, hereby certify that:

- The information contained in this drawing / document is in compliance with approved drawings and design.
- The new water and sewerage works defined by this drawing have been designed and constructed in accordance with the SEQ Code.
- This represents an accurate record of as-constructed works.
- I accept responsibility for the information contained in this drawing / document.

RPEQ (signature) RPEQ No. _____ Date: _____


REGISTERED SURVEYOR'S CERTIFICATION

I, _____, hereby certify that the vertical and horizontal locations and dimensions shown on this plan are a true and correct record and were located by survey.

Registered Surveyor (sig) Reg. Surveyor No. _____ Date: _____

- LEGEND**
- PVC-U TYPE 'G' MAINTENANCE SHAFT
 - MAINTENANCE HOLE (Ø1050 PRE-CAST CONCRETE)
 - LONG/SHORT RADIUS BEND
 - WYE JUNCTION (150x150 WITH 150x100 REDUCER)
 - END CAP
 - RETICULATION MAIN (DN150 PVC-U SN8)
 - RETICULATION MAIN (DN150 PVC-U PN12)
 - RETICULATION MAIN (DN250 PE-100 SDR21)
 - HOUSE CONNECTION (DN100 PVC-U SN10)

COORDINATE DATUM NOTE:
 HORIZONTAL COORDINATES(E,N) SUPPLIED ARE MAPPING GRID OF AUSTRALIA(MGA), ZONE 56 BASED ON THE UNIVERSAL TRANSVERSE MERCATOR PROJECTION AND THE GEOCENTRIC DATUM OF AUSTRALIA 1994.

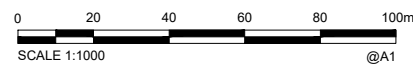

AS CONSTRUCTED

A1	0	05/06/2023	AS CONSTRUCTED DETAILS	LG	BS				
	INDEX	DATE	REVISIONS	DRAWN	CHECKED	PASSED	INITIALS	DATE	

DRAWN	LG	05/06/2023
CHECKED	BS	05/06/2023
PASSED		



LEVEL 2, 1 INNOVATION PARKWAY, BIRTNYA, QLD, 4575
0754.135300



Unitywater

2018012748511
RIDGEVIEW - STAGE 8
AS CONSTRUCTED
SEWER RETICULATION

SHEET 5 OF 5 SHEETS	SCALE 1:250
REVISION DATE 05/06/2023	REVISION 0
DISCIPLINE CODE C	
DRAWING NO. U-2022-4385-5	