


UNITYWATER PROJECT NUMBER 2018012748S11

RIDGEVIEW - STAGE 9

SEWER AND WATER

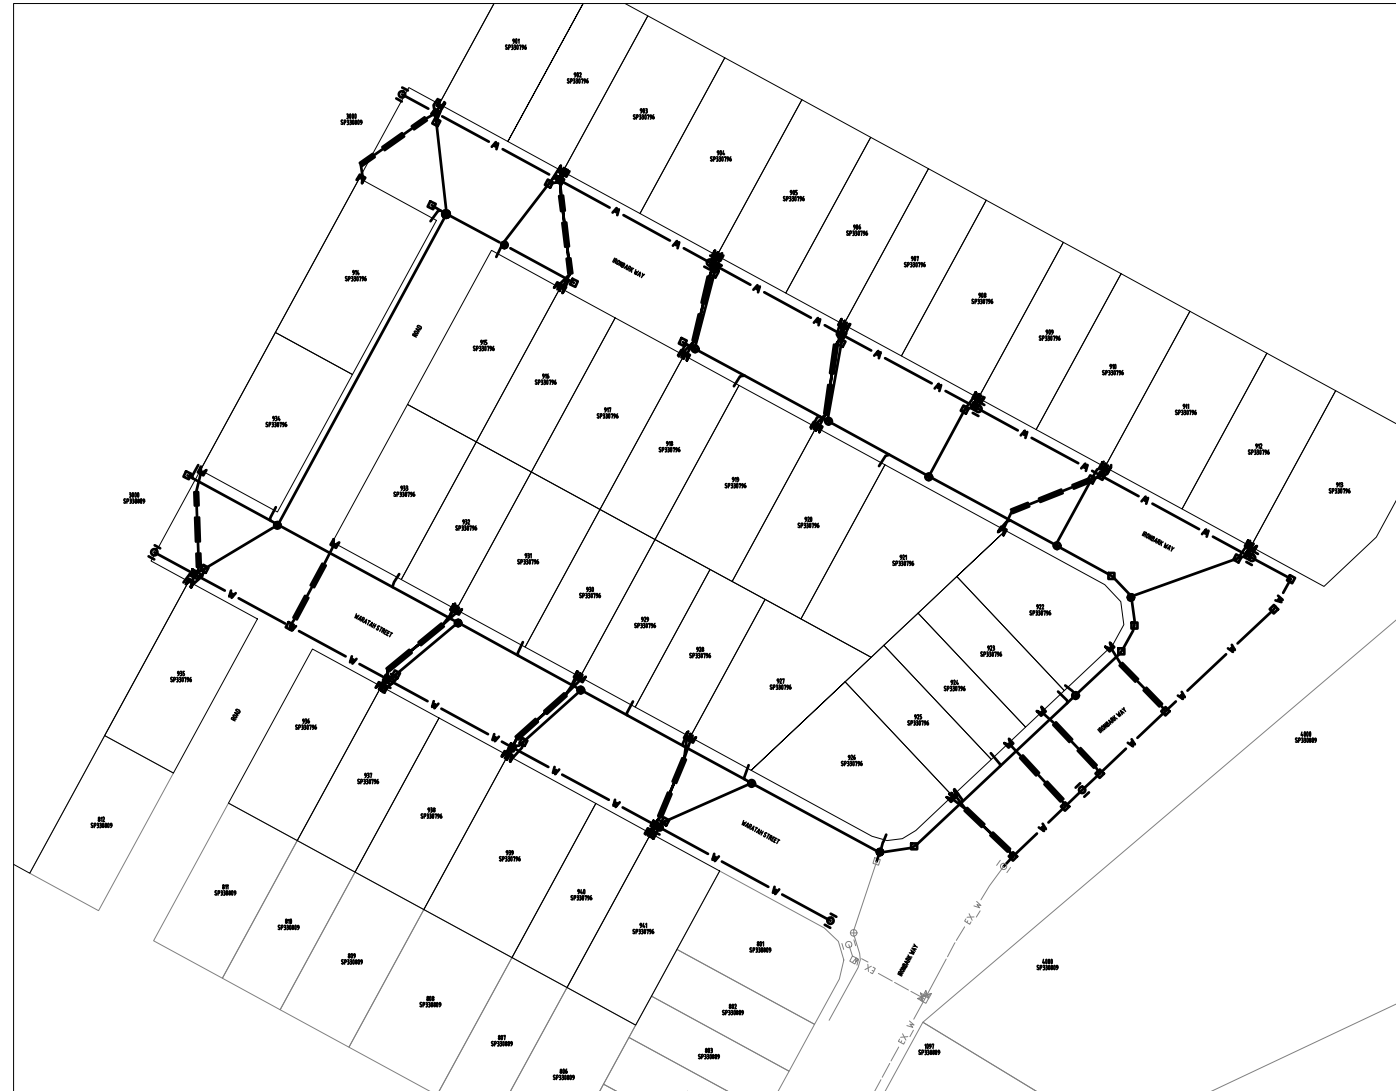

DRAWING INDEX	
DRAWING NUMBER	DESCRIPTION
U-2022-4385-1	LOCALITY PLAN AND DRAWING INDEX
U-2022-4385-2	WATER PLAN - SHEET 1
U-2022-4385-3	WATER PLAN - SHEET 2
U-2022-4385-4	SEWER PLAN - SHEET 1
U-2022-4385-5	SEWER PLAN - SHEET 2

COORDINATE DATUM NOTE:
 HORIZONTAL COORDINATES(E,N) SUPPLIED ARE MAPPING GRID OF AUSTRALIA(MGA), ZONE 56 BASED ON THE UNIVERSAL TRANSVERSE MERCATOR PROJECTION AND THE GEOCENTRIC DATUM OF AUSTRALIA 1994.

ENGINEER'S CERTIFICATION

I, _____, hereby certify that:

1. The information contained in this drawing / document is in compliance with approved drawings and design;
2. The new water and sewerage works defined by this drawing have been designed and constructed in accordance with the SEQ Code;
3. This represents an accurate record of as-constructed works;
4. I accept responsibility for the information contained in this drawing / document.

 RPEQ (signature) RPEQ No. _____ Date: _____

REGISTERED SURVEYOR'S CERTIFICATION

I, _____, hereby certify that the vertical and horizontal locations and dimensions shown on this plan are a true and correct record and were located by survey.

 Registered Surveyor (sig) Reg. Surveyor No. _____ Date: _____



AS CONSTRUCTED

A1									
	INDEX	DATE	REVISIONS	DRAWN	CHECKED	PASSED	INITIALS	DATE	
	0	09/06/2023	AS CONSTRUCTED DETAILS	LG	BS	PASSED			

DRAWN	LG	09/06/2023	CHECKED	BS	09/06/2023	PASSED			




LEVEL 2, 1 INNOVATION
 PARKWAY, BIRTNYA, QLD, 4575
 0754435300



Unitywater

2018012748S11
 RIDGEVIEW - STAGE 9
 AS CONSTRUCTED
 SEWER & WATER

SHEET 1	OF 5	SHEETS	SCALE 1:250
REVISION DATE	09/06/2023	REVISION	0
DISCIPLINE CODE	C	DRAWING NO.	U-2022-4385-1

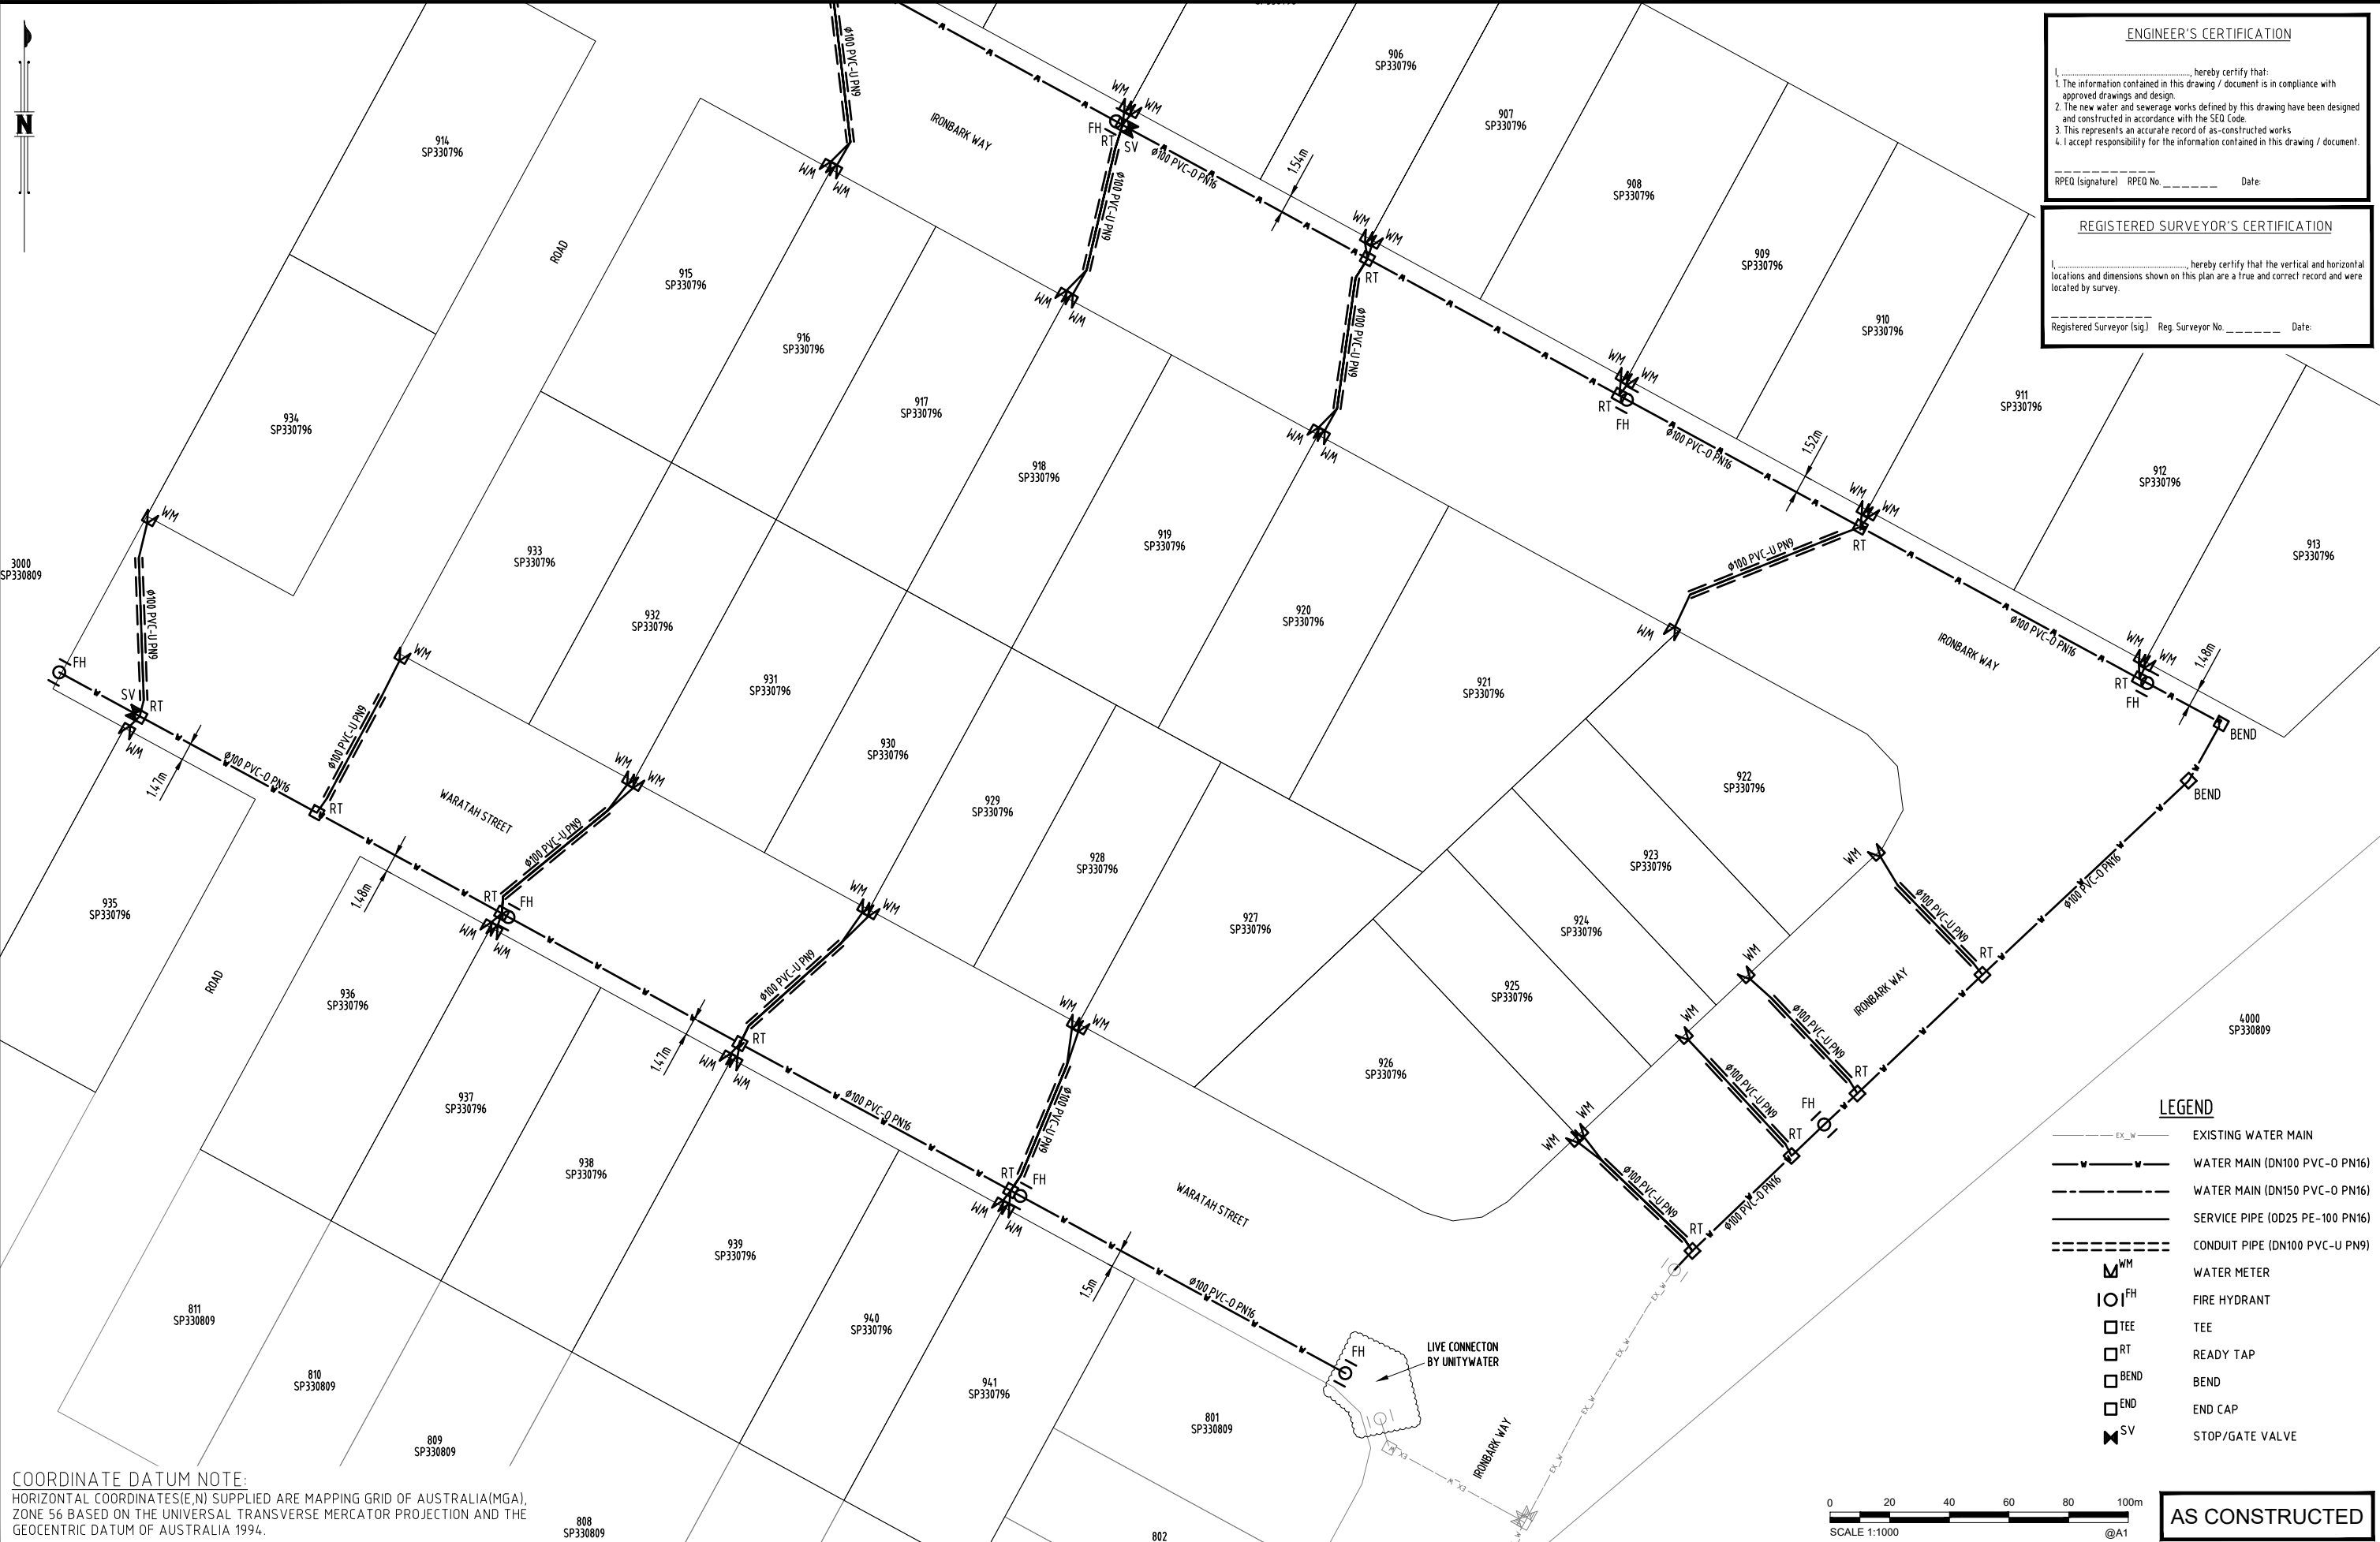

ENGINEER'S CERTIFICATION

I, _____, hereby certify that:

- The information contained in this drawing / document is in compliance with approved drawings and design.
- The new water and sewerage works defined by this drawing have been designed and constructed in accordance with the SEQ Code.
- This represents an accurate record of as-constructed works.
- I accept responsibility for the information contained in this drawing / document.

RPEQ (signature) RPEQ No. _____ Date: _____

REGISTERED SURVEYOR'S CERTIFICATION


I, _____, hereby certify that the vertical and horizontal locations and dimensions shown on this plan are a true and correct record and were located by survey.

Registered Surveyor (sig) Reg. Surveyor No. _____ Date: _____

LEGEND

- EX_W EXISTING WATER MAIN
- WATER MAIN (DN100 PVC-O PN16)
- WATER MAIN (DN150 PVC-O PN16)
- SERVICE PIPE (OD25 PE-100 PN16)
- CONDUIT PIPE (DN100 PVC-U PN9)
- WATER METER
- FIRE HYDRANT
- TEE
- READY TAP
- BEND
- END CAP
- STOP/GATE VALVE

COORDINATE DATUM NOTE:
 HORIZONTAL COORDINATES(E,N) SUPPLIED ARE MAPPING GRID OF AUSTRALIA(MGA), ZONE 56 BASED ON THE UNIVERSAL TRANSVERSE MERCATOR PROJECTION AND THE GEOCENTRIC DATUM OF AUSTRALIA 1994.

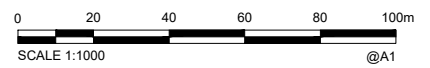

AS CONSTRUCTED

A1	0	09/06/2023	AS CONSTRUCTED DETAILS	LG	BS	
	INDEX	DATE	REVISIONS	DRAWN	CHECKED	PASSED

DRAWN	LG	09/06/2023
CHECKED	BS	09/06/2023
PASSED		
INITIALS	DATE	



LEVEL 2, 1 INNOVATION PARKWAY, BIRTNYA, QLD, 4575
 0754.135300



Unitywater
 2018012748511
 RIDGEVIEW - STAGE 8
 AS CONSTRUCTED
 WATER SUPPLY

SHEET 3 OF 5 SHEETS	SCALE 1:250
REVISION DATE 09/06/2023	REVISION 0
DISCIPLINE CODE C	
DRAWING NO. U-2022-4385-3	

LEGEND

- PVC-U TYPE 'G' MAINTENANCE SHAFT
- MAINTENANCE HOLE (Ø1050 PRE-CAST CONCRETE)
- LONG/SHORT RADIUS BEND
- WYE JUNCTION (150x150 WITH 150x100 REDUCER)
- END CAP
- RETICULATION MAIN (DN150 PVC-U SN8)
- RETICULATION MAIN (DN150 PVC-U PN12)
- RETICULATION MAIN (DN250 PE-100 SDR21)
- HOUSE CONNECTION (DN100 PVC-U SN10)

ENGINEER'S CERTIFICATION

I, _____, hereby certify that:


- The information contained in this drawing / document is in compliance with approved drawings and design.
- The new water and sewerage works defined by this drawing have been designed and constructed in accordance with the SEQ Code.
- This represents an accurate record of as-constructed works.
- I accept responsibility for the information contained in this drawing / document.

RPEQ (signature) RPEQ No. _____ Date: _____

REGISTERED SURVEYOR'S CERTIFICATION

I, _____, hereby certify that the vertical and horizontal locations and dimensions shown on this plan are a true and correct record and were located by survey.

Registered Surveyor (sig) Reg. Surveyor No. _____ Date: _____

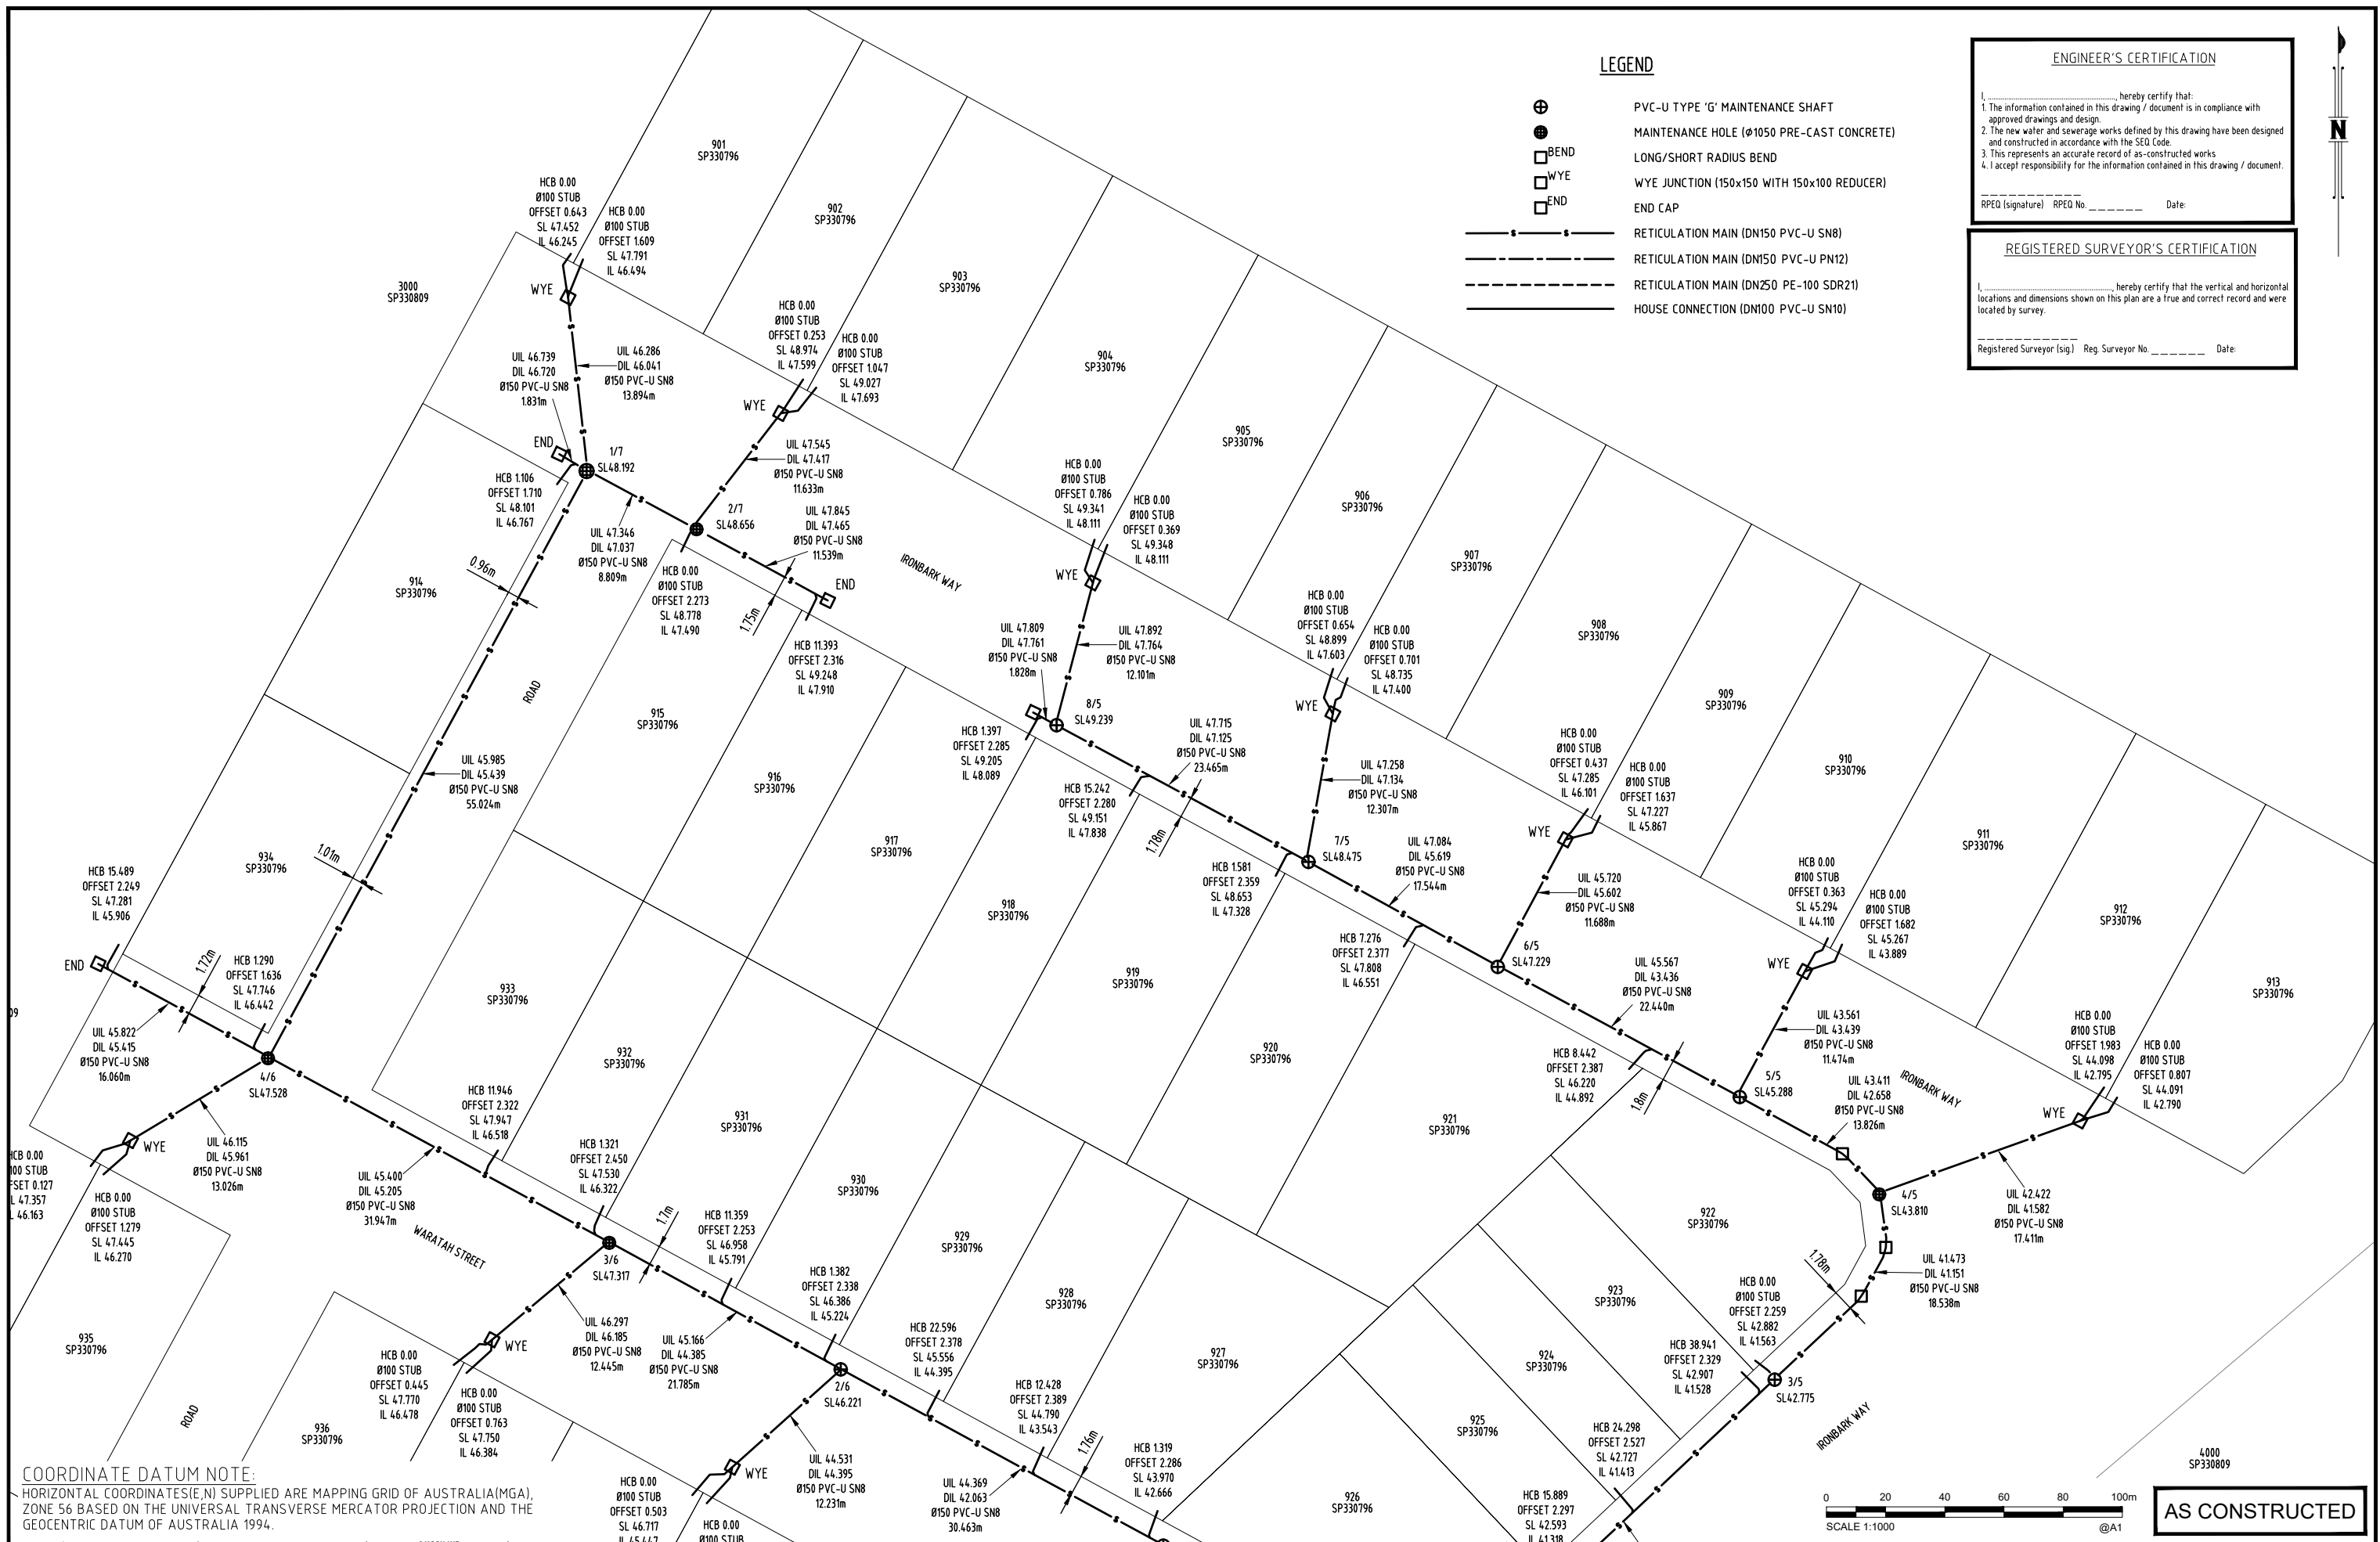

COORDINATE DATUM NOTE:
 HORIZONTAL COORDINATES(E,N) SUPPLIED ARE MAPPING GRID OF AUSTRALIA(MGA), ZONE 56 BASED ON THE UNIVERSAL TRANSVERSE MERCATOR PROJECTION AND THE GEOCENTRIC DATUM OF AUSTRALIA 1994.

AS CONSTRUCTED

A1	0	09/06/2023	AS CONSTRUCTED DETAILS	LG	BS		
	INDEX	DATE	REVISIONS	DRAWN	CHECKED	PASSED	

DRAWN	LG	09/06/2023
CHECKED	BS	09/06/2023
PASSED		

LEVEL 2, 1 INNOVATION PARKWAY, BIRTMYA, QLD, 4575
0754.135300

Unitywater

2018012748511
 RIDGEVIEW - STAGE 8
 AS CONSTRUCTED
 SEWER RETICULATION

SHEET 4 OF 5 SHEETS	SCALE 1:250
REVISION DATE 09/06/2023	REVISION 0
DISCIPLINE CODE C	
DRAWING NO. U-2022-4385-4	

