

DRAWING REVISIONS		REFERENCE DRAWINGS		DESIGN FILE No.	DESIGNED
REV.	REVISION DESCRIPTION	DRG. No.	DESCRIPTION	CONSTRUCT. No.	DATE
0	AS-CONSTRUCTED DRAWINGS				
				SURVEY FILE No.	DRAWN ARR
				FIELD BOOK	DATE 07/08/2024
				LOG BOOK	CHECKED BAS
				LEVEL DATUM	DATE 07/08/2024
				DATUM	



THIS WORK WAS PREPARED BY:
 Lion Systems on behalf of SHADFORTH

SCALE 1:250 ORIGINAL SIZE A1

MORETON BAY REGIONAL COUNCIL
 PINE DISTRICT OFFICE
 220 GYMPIE ROAD STRATHPINE QLD 4500
 PO BOX 159 CABOOLTURE QLD 4510
 Telephone: (07) 3480 8686
 Fax: (07) 3480 6710

ROADS AND DRAINAGE
AS CONSTRUCTED
RIDGEVIEW -STAGE 11
RAYNBIRD ROAD, NARANGBA


MBRC SUBDIVISION REFERENCE	
DA/2023/4525	
No. 1 OF 2 PLANS	
ASCAN GRID NUMBER	REV.
	0

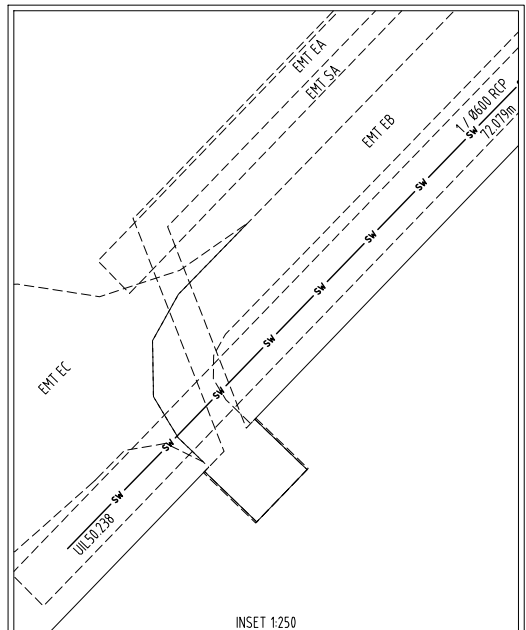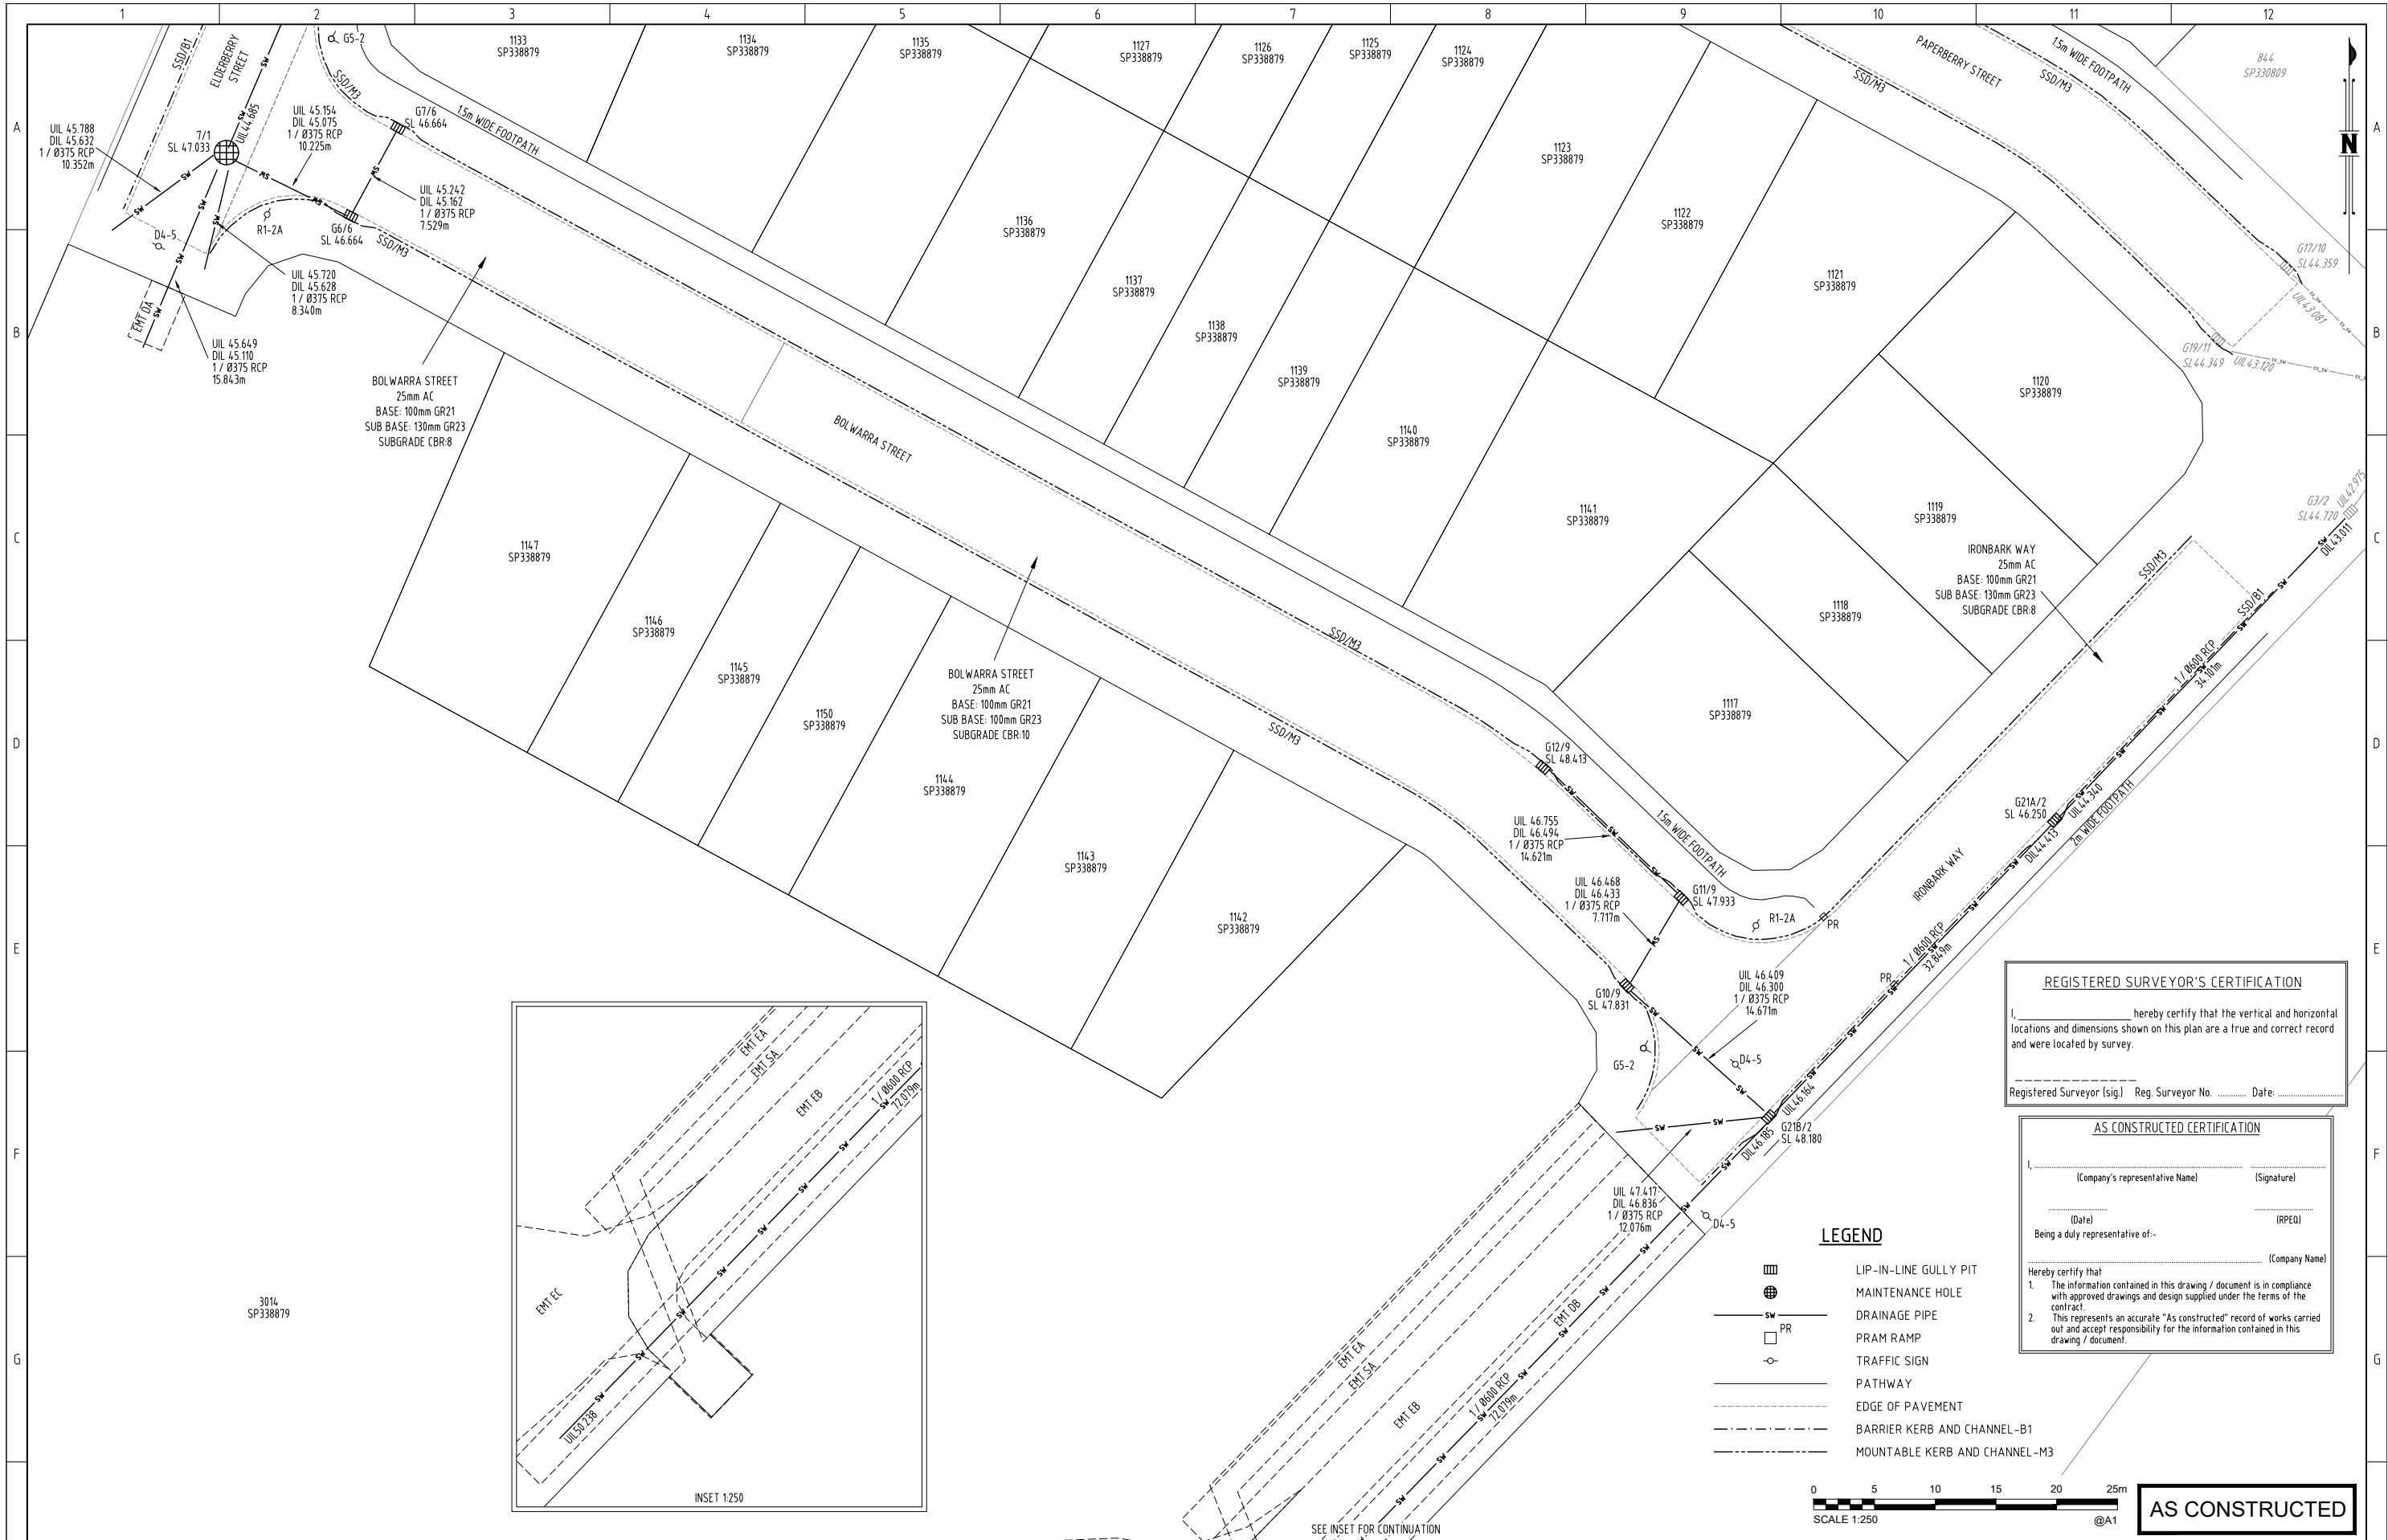

REGISTERED SURVEYOR'S CERTIFICATION
 I, _____ hereby certify that the vertical and horizontal locations and dimensions shown on this plan are a true and correct record and were located by survey.
 Registered Surveyor (sig.) Reg. Surveyor No. _____ Date: _____

AS CONSTRUCTED CERTIFICATION
 I, _____ (Company's representative Name) _____ (Signature)
 _____ (Date) _____ (RPEQ)
 Being a duly representative of - _____ (Company Name)
 Hereby certify that
 1. The information contained in this drawing / document is in compliance with approved drawings and design supplied under the terms of the contract.
 2. This represents an accurate "As constructed" record of works carried out and accept responsibility for the information contained in this drawing / document.

- LEGEND**
- LIP-IN-LINE GULLY PIT
 - MAINTENANCE HOLE
 - DRAINAGE PIPE
 - PRAM RAMP
 - TRAFFIC SIGN
 - PATHWAY
 - EDGE OF PAVEMENT
 - BARRIER KERB AND CHANNEL-B1
 - MOUNTABLE KERB AND CHANNEL-M3

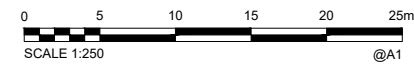

AS CONSTRUCTED

DRAWING REVISIONS		REFERENCE DRAWINGS		DESIGN FILE No.		DESIGNED	
REV.	REVISION DESCRIPTION	DRG. No.	DESCRIPTION	CONSTRUCT. No.	DATE	DATE	ARR
0	AS-CONSTRUCTED DRAWINGS					07/08/2024	

THIS WORK WAS PREPARED BY:
 Lion Systems on behalf of SHADFORTH
 SCALE 1:250 ORIGINAL SIZE A1

MORETON BAY REGIONAL COUNCIL
 PINE DISTRICT OFFICE
 220 GYMPIE ROAD STRATHPINE QLD 4500
 PO BOX 159 CABOOLTURE QLD 4510
 Telephone: (07) 3480 8686
 Fax: (07) 3480 6710

ROADS AND DRAINAGE
AS CONSTRUCTED
RIDGEVIEW -STAGE 11
RAYNBIRD ROAD, NARANGBA

MBRC SUBDIVISION REFERENCE	
DA/2023/4525	
No. 2 OF 2 PLANS	
ASCON GRID NUMBER	REV.
	0