

PSM1934.14
 E: 492230.165
 N: 6993766.408
 RL: 39.327m

LEGEND

- EX_W — EXISTING WATER MAIN
- W — WATER MAIN (DN100 PVC-O PN16)
- - - WATER MAIN (DN100 DICL PN35)
- S — SERVICE PIPE (OD25 PE-100 PN16)
- - - CONDUIT PIPE (DN100 PVC-U PN9)
- WM WATER METER - 20mm ITRON
- I O I FH FIRE HYDRANT
- TEE TEE
- RT READY TAP
- BEND BEND
- DEC END CAP
- ✕ SV STOP VALVE



ENGINEER'S CERTIFICATION

I, _____, hereby certify that:

- The information contained in this drawing / document is in compliance with approved drawings and design.
- The new water and sewerage works defined by this drawing have been designed and constructed in accordance with the SEQ Code.
- This represents an accurate record of as-constructed works.
- I accept responsibility for the information contained in this drawing / document.

RPEQ (signature) RPEQ No. _____ Date: _____


REGISTERED SURVEYOR'S CERTIFICATION

I, _____, hereby certify that the vertical and horizontal locations and dimensions shown on this plan are a true and correct record and were located by survey.

Registered Surveyor (sig) Reg. Surveyor No. _____ Date: _____

NOTE:
 ALL WATER CONNECTIONS AT THE LOT ARE
 Ø25 PE-100 PN16 UNLESS OTHERWISE NOTED

COORDINATE DATUM NOTE:
 HORIZONTAL COORDINATES (E, N) SUPPLIED ARE MAPPING GRID OF AUSTRALIA (MGA), ZONE 56 BASED ON THE UNIVERSAL TRANSVERSE MERCATOR PROJECTION AND THE GEOCENTRIC DATUM OF AUSTRALIA 2020.

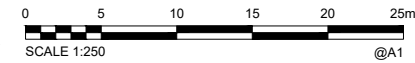

AS CONSTRUCTED

A1	AS CONSTRUCTED DETAILS		
	INDEX	DATE	REVISIONS

DRAWN	ARR	31/07/2024
CHECKED	BAS	05/08/2024
PASSED		
INITIALS	DATE	



LEVEL 2, 1 INNOVATION PARKWAY, BIRTNIA, QLD, 4575
 0754.135300




Unitywater
 2018012748516
 RIDGEVIEW - STAGE 11
 AS CONSTRUCTED
 WATER RETICULATION

SHEET 1 OF 4 SHEETS	SCALE 1:250
REVISION DATE	REVISION
DISCIPLINE CODE	C
DRAWING NO.	U-2023-5252

PSM193414
 E: 4.92230.165
 N: 6.993766.408
 RL: 39.327m

FOR CONTINUATION REFER SHEET 1

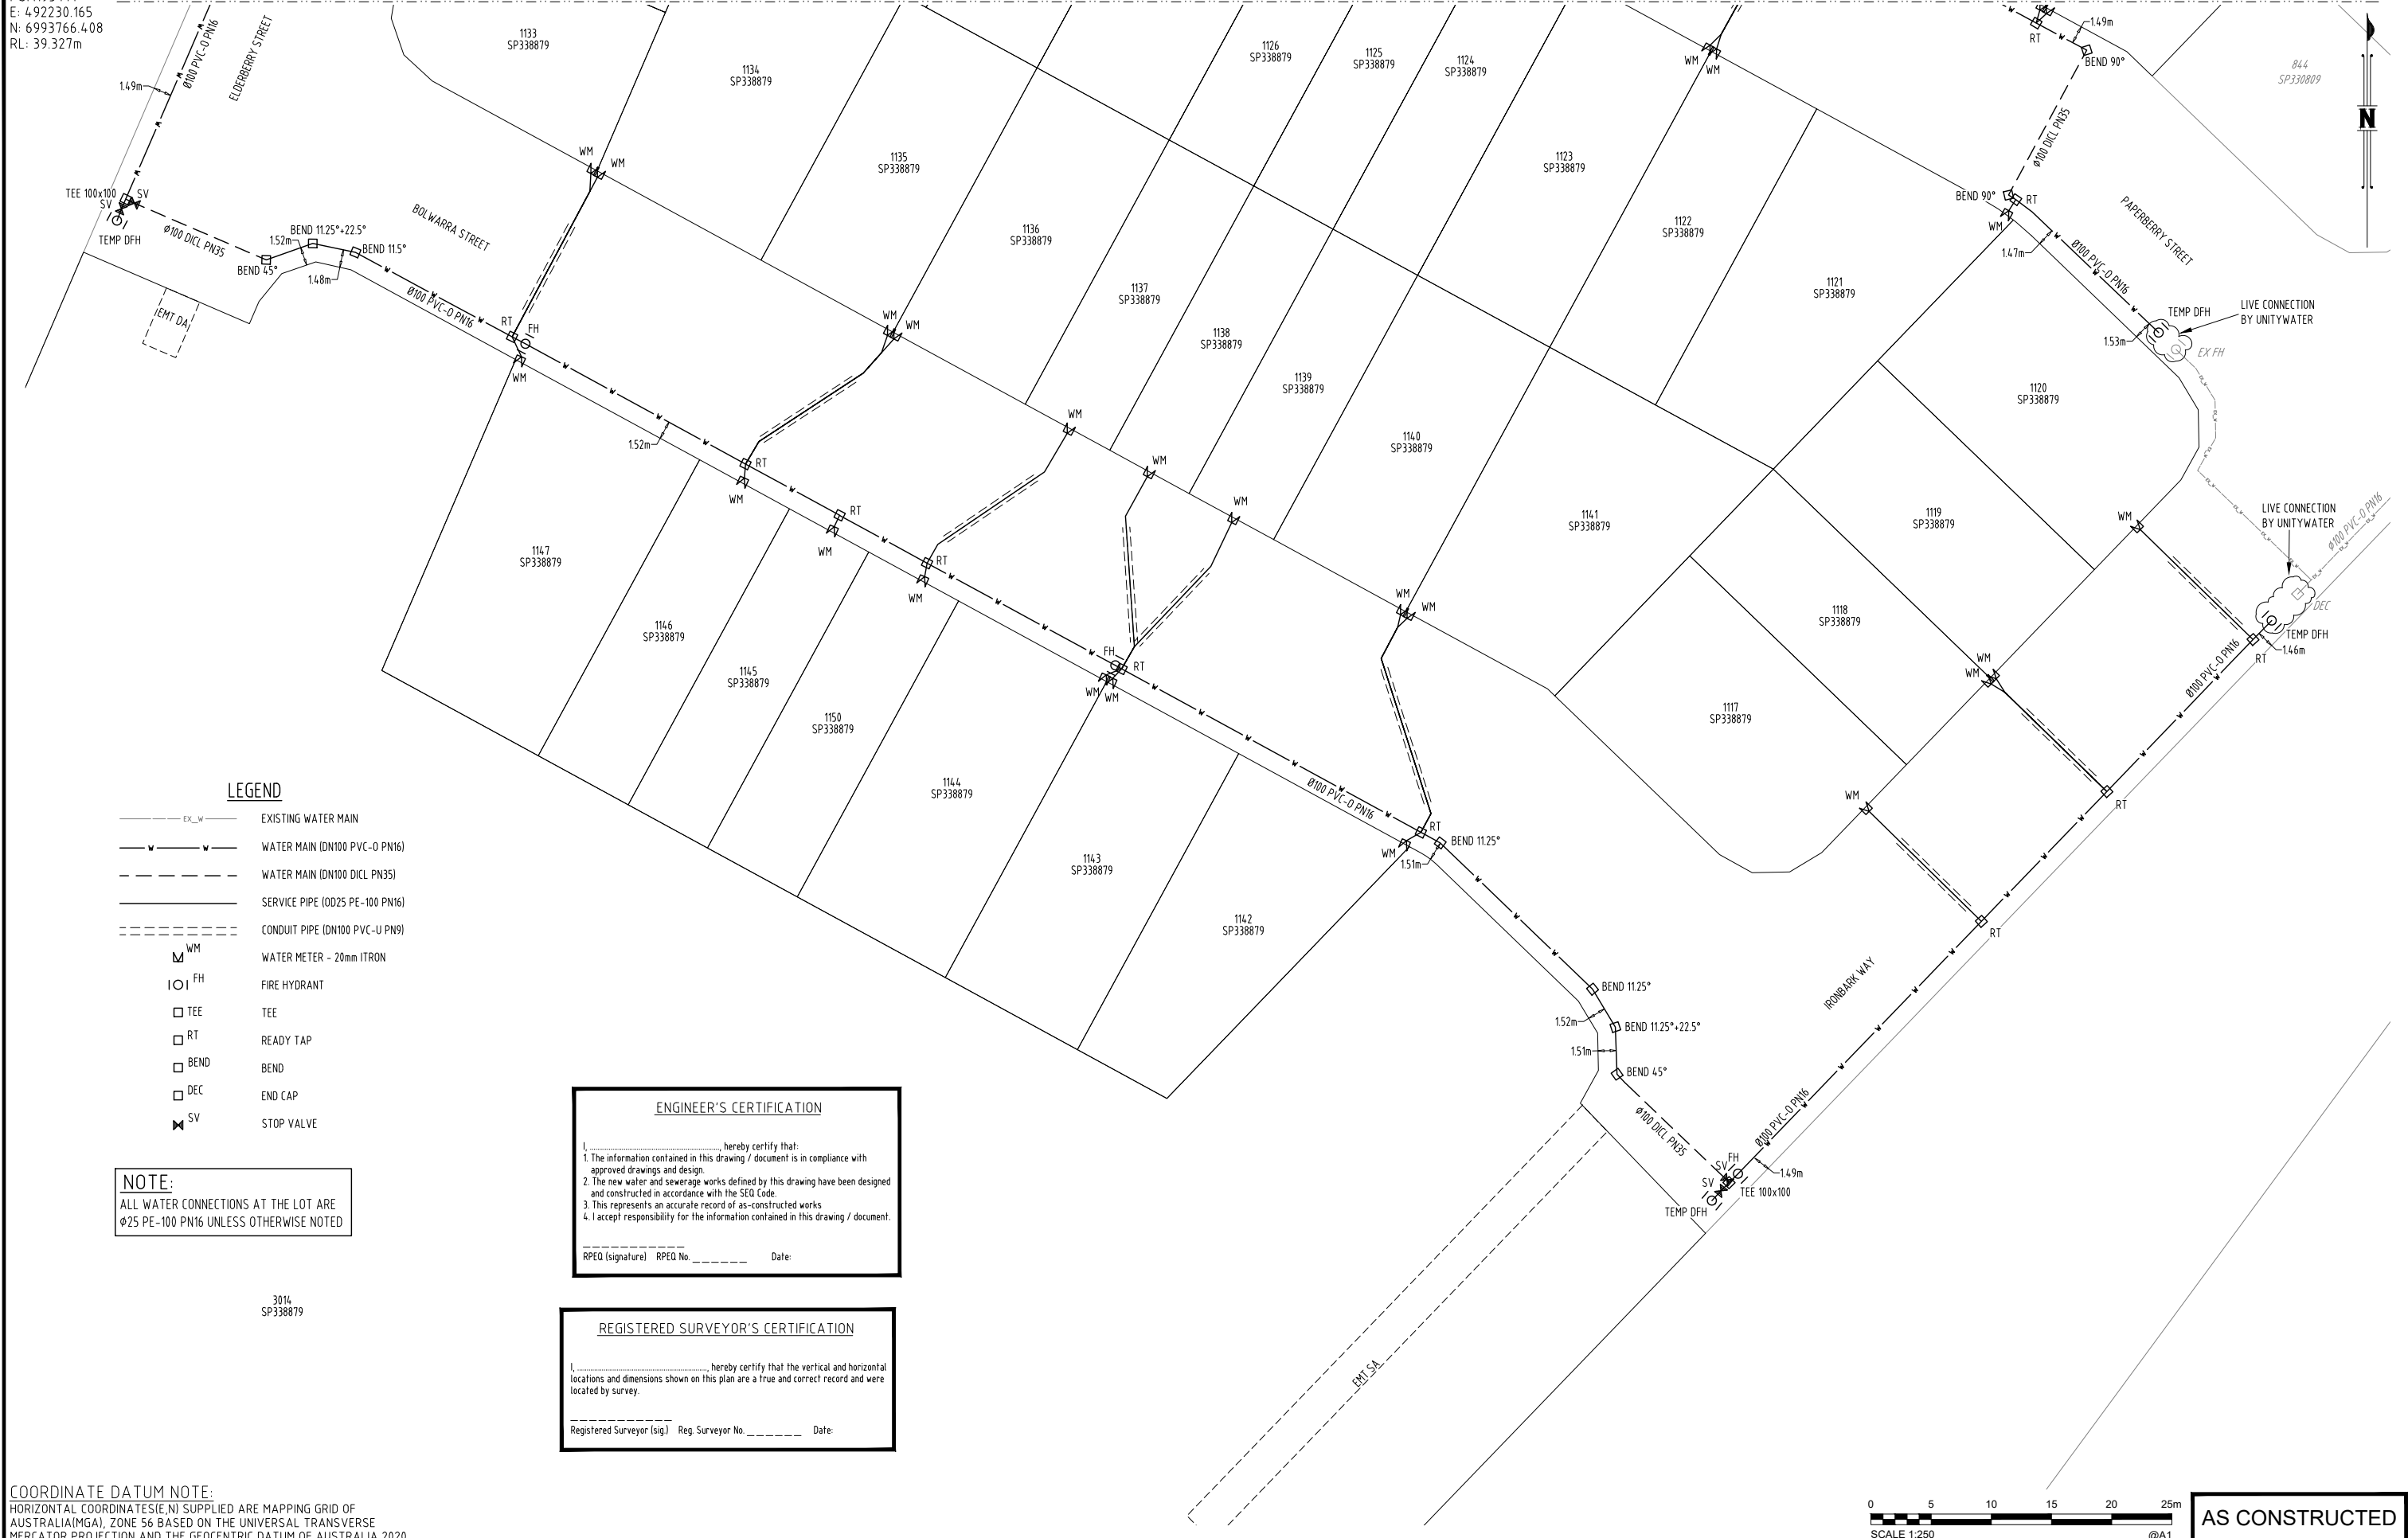

LEGEND


- EX. W — EXISTING WATER MAIN
- W — WATER MAIN (DN100 PVC-0 PN16)
- - - WATER MAIN (DN100 DICL PN35)
- S — SERVICE PIPE (OD25 PE-100 PN16)
- - - CONDUIT PIPE (DN100 PVC-U PN9)
- WM WATER METER - 20mm ITRON
- FH FIRE HYDRANT
- TEE TEE
- RT READY TAP
- BEND BEND
- DEC END CAP
- SV STOP VALVE

NOTE:
 ALL WATER CONNECTIONS AT THE LOT ARE
 Ø25 PE-100 PN16 UNLESS OTHERWISE NOTED

ENGINEER'S CERTIFICATION
 I, _____, hereby certify that:
 1. The information contained in this drawing / document is in compliance with approved drawings and design.
 2. The new water and sewerage works defined by this drawing have been designed and constructed in accordance with the SEQ Code.
 3. This represents an accurate record of as-constructed works.
 4. I accept responsibility for the information contained in this drawing / document.
 RPEQ (signature) RPEQ No. _____ Date: _____

REGISTERED SURVEYOR'S CERTIFICATION
 I, _____, hereby certify that the vertical and horizontal locations and dimensions shown on this plan are a true and correct record and were located by survey.
 Registered Surveyor (sig) Reg. Surveyor No. _____ Date: _____

COORDINATE DATUM NOTE:
 HORIZONTAL COORDINATES (E,N) SUPPLIED ARE MAPPING GRID OF AUSTRALIA (MGA), ZONE 56 BASED ON THE UNIVERSAL TRANSVERSE MERCATOR PROJECTION AND THE GEOCENTRIC DATUM OF AUSTRALIA 2020.

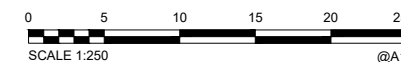

AS CONSTRUCTED

A1	INDEX	DATE	REVISIONS	DRAWN	CHECKED	PASSED

DRAWN	ARR	31/07/2024
CHECKED	BAS	05/08/2024
PASSED		



LEVEL 2, 1 INNOVATION PARKWAY, BIRTNYA, QLD, 4575
 0754.135300



Unitywater

2018012748S16
 RIDGEVIEW - STAGE 11
 AS CONSTRUCTED
 WATER RETICULATION

SHEET 2 OF 4 SHEETS	SCALE 1:250
REVISION DATE	REVISION
DISCIPLINE CODE	C
DRAWING NO.	U-2023-5252

PSM1934.14
 E: 492230.165
 N: 6993766.408
 RL: 39.327m

LEGEND

- MAINTENANCE SHAFT (Ø600 LMDPE SMARTSTREAM POOPIT ON Ø300 UPVC RISER)
- MAINTENANCE HOLE (Ø1050 PRECAST CONCRETE TYPE P2)
- HORIZONTAL BEND
- WYE JUNCTION (150x150 WITH 150-100 REDUCER)
- EXTERNAL DEAD END
- CONNECTOR
- 150-100 REDUCER
- RETICULATION MAIN (DN150 PVC-U SN8)
- RETICULATION MAIN (DN150 PVC-U PN12)
- EXISTING SEWER MAIN

ENGINEER'S CERTIFICATION

I, _____, hereby certify that:

- The information contained in this drawing / document is in compliance with approved drawings and design.
- The new water and sewerage works defined by this drawing have been designed and constructed in accordance with the SEQ Code.
- This represents an accurate record of as-constructed works
- I accept responsibility for the information contained in this drawing / document.


RPEQ (signature) RPEQ No. _____ Date: _____

REGISTERED SURVEYOR'S CERTIFICATION


I, _____, hereby certify that the vertical and horizontal locations and dimensions shown on this plan are a true and correct record and were located by survey.

Registered Surveyor (sig) Reg. Surveyor No. _____ Date: _____

NOTE:
 REFER TO SEQ-SEW-1104-1 FOR TYPICAL HOUSE CONNECTION DETAILS ON DUAL HOUSE CONNECTIONS

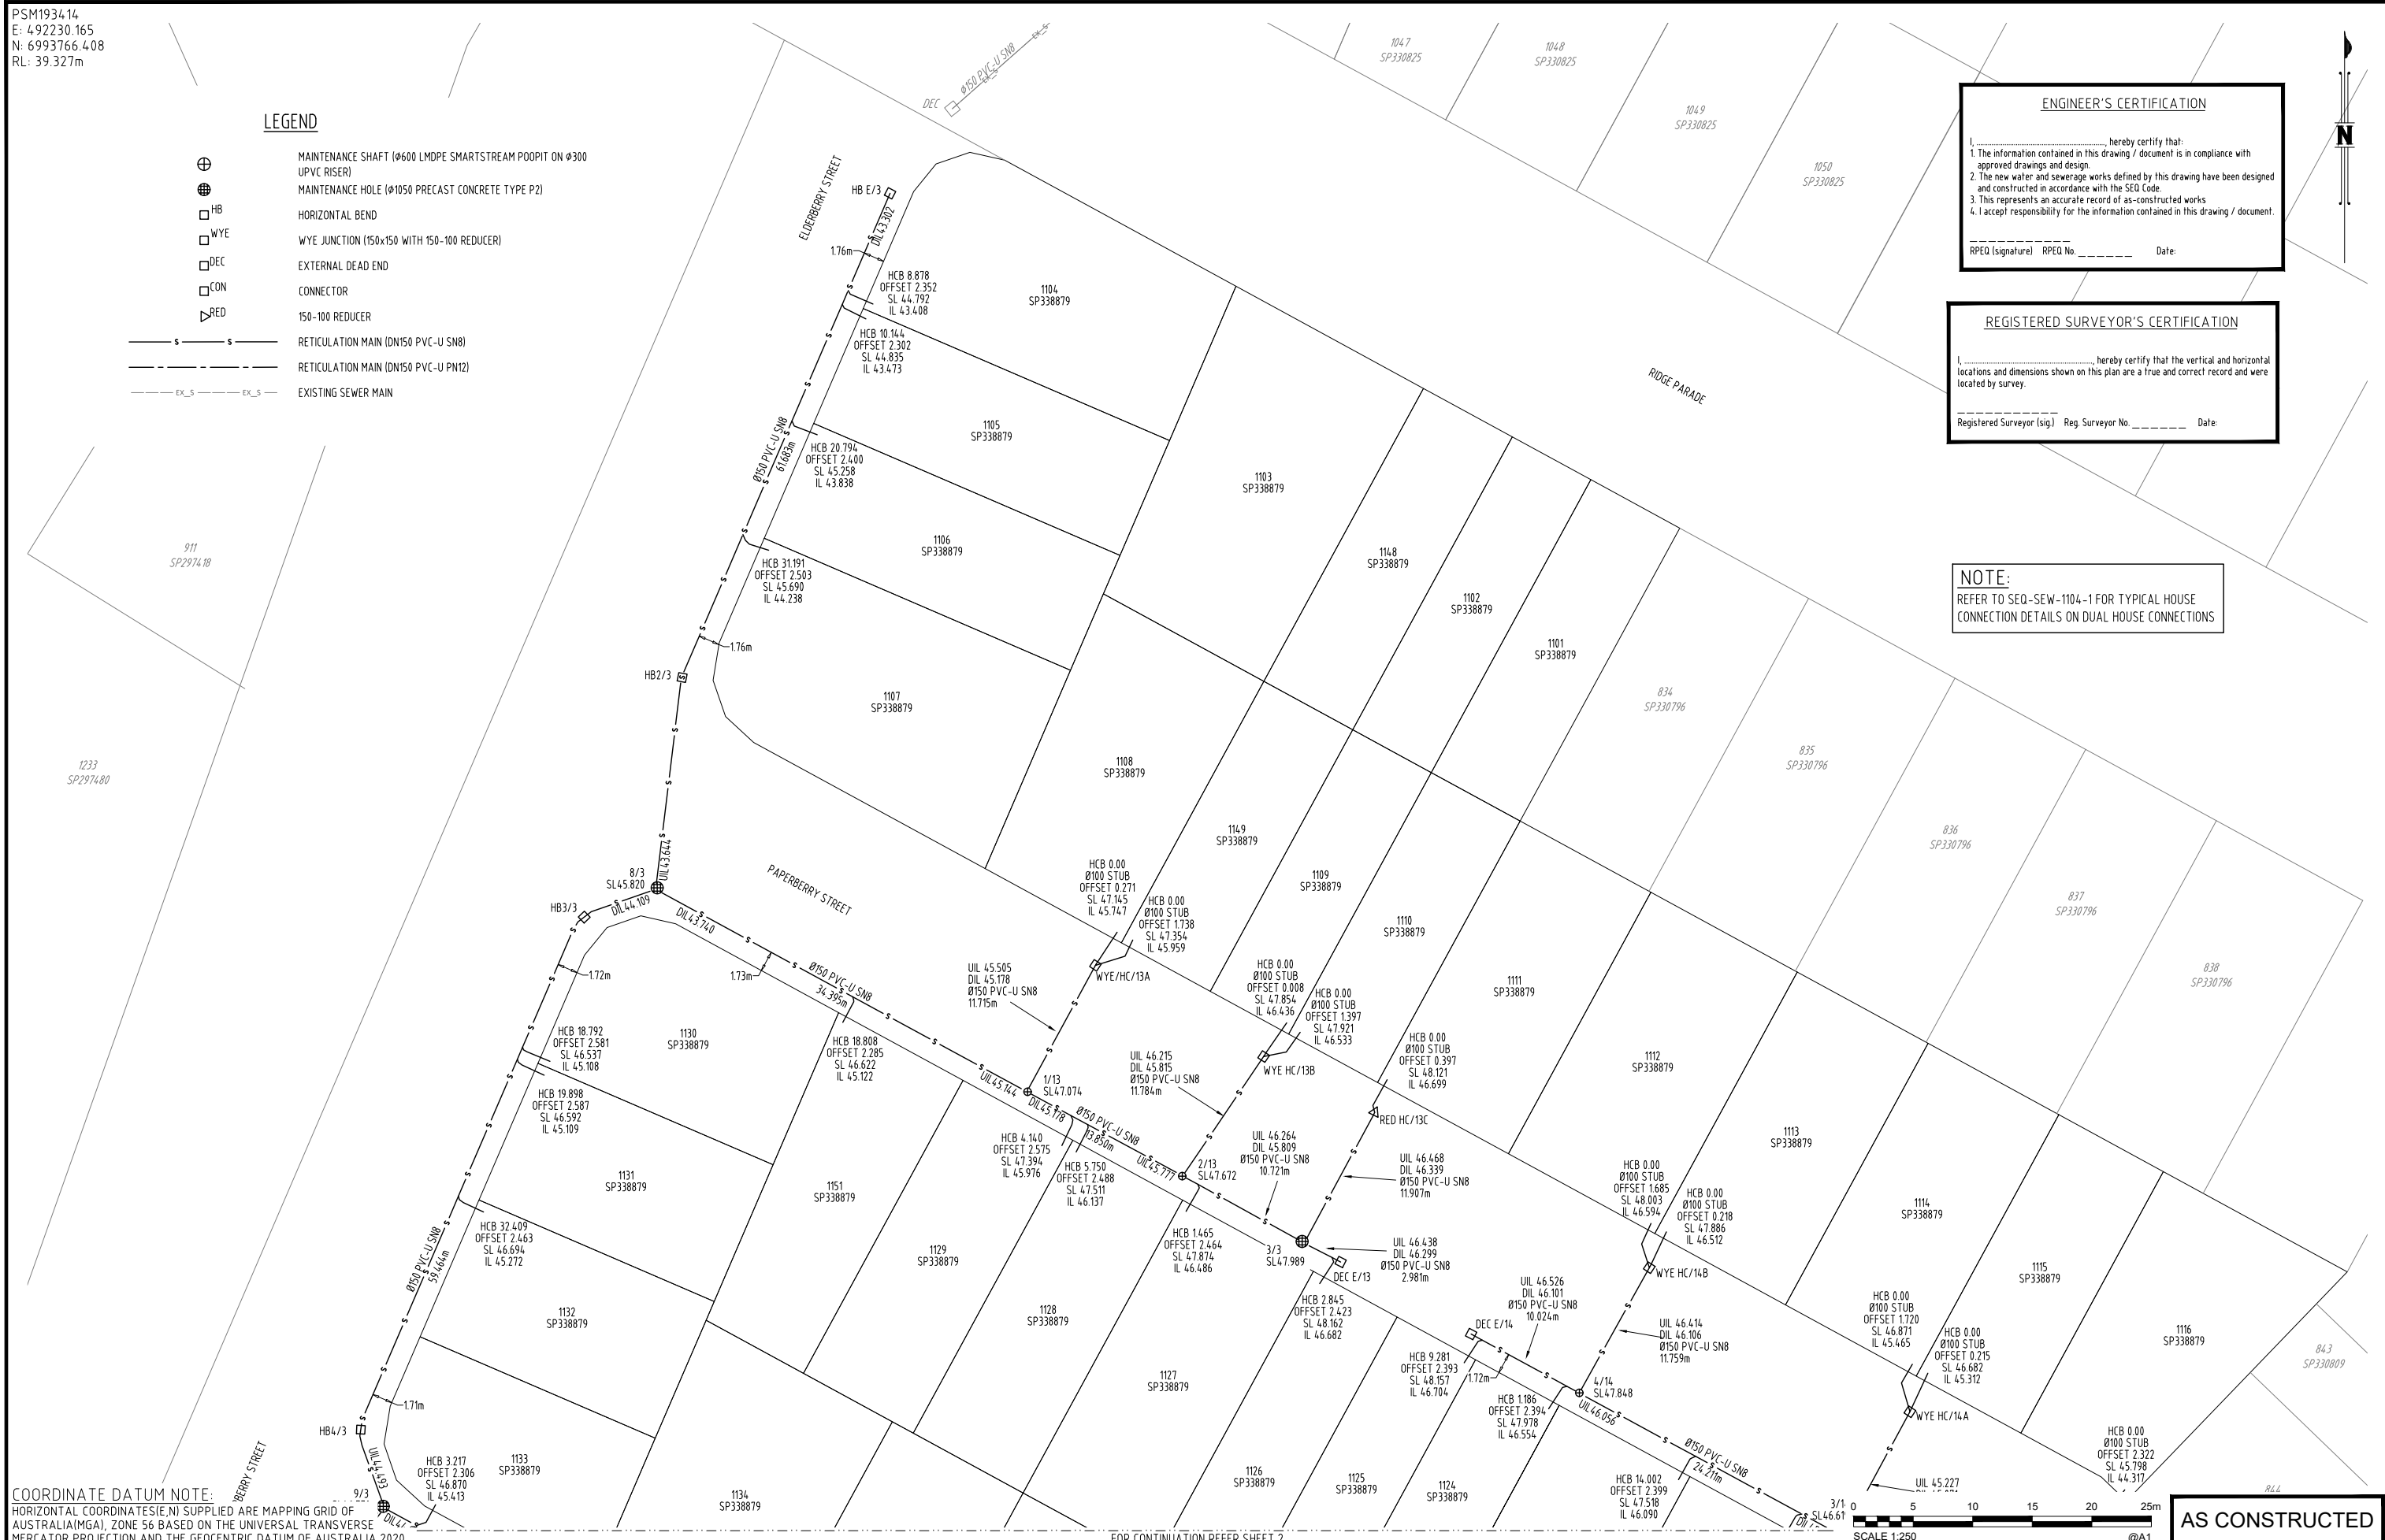

COORDINATE DATUM NOTE:
 HORIZONTAL COORDINATES (E,N) SUPPLIED ARE MAPPING GRID OF AUSTRALIA (MGA), ZONE 56 BASED ON THE UNIVERSAL TRANSVERSE MERCATOR PROJECTION AND THE GEOCENTRIC DATUM OF AUSTRALIA 2020.

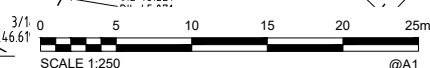

AS CONSTRUCTED

FOR CONTINUATION REFER SHEET 2

A1	AS CONSTRUCTED DETAILS		
	INDEX	DATE	REVISIONS

DRAWN	ARR	31/07/2024
CHECKED	BAS	05/08/2024
PASSED		



LEVEL 2, 1 INNOVATION PARKWAY, BIRTNYA, QLD, 4575
 0754.135300




Unitywater
 2018012748516
 RIDGEVIEW - STAGE 11
 AS CONSTRUCTED
 SEWERAGE RETICULATION

SHEET 3 OF 4 SHEETS	SCALE 1:250
REVISION DATE	REVISION
DISCIPLINE CODE	C
DRAWING NO.	U-2023-5252

PSM1934.14
 E: 492230.165
 N: 6993766.408
 RL: 39.327m

FOR CONTINUATION REFER SHEET 1

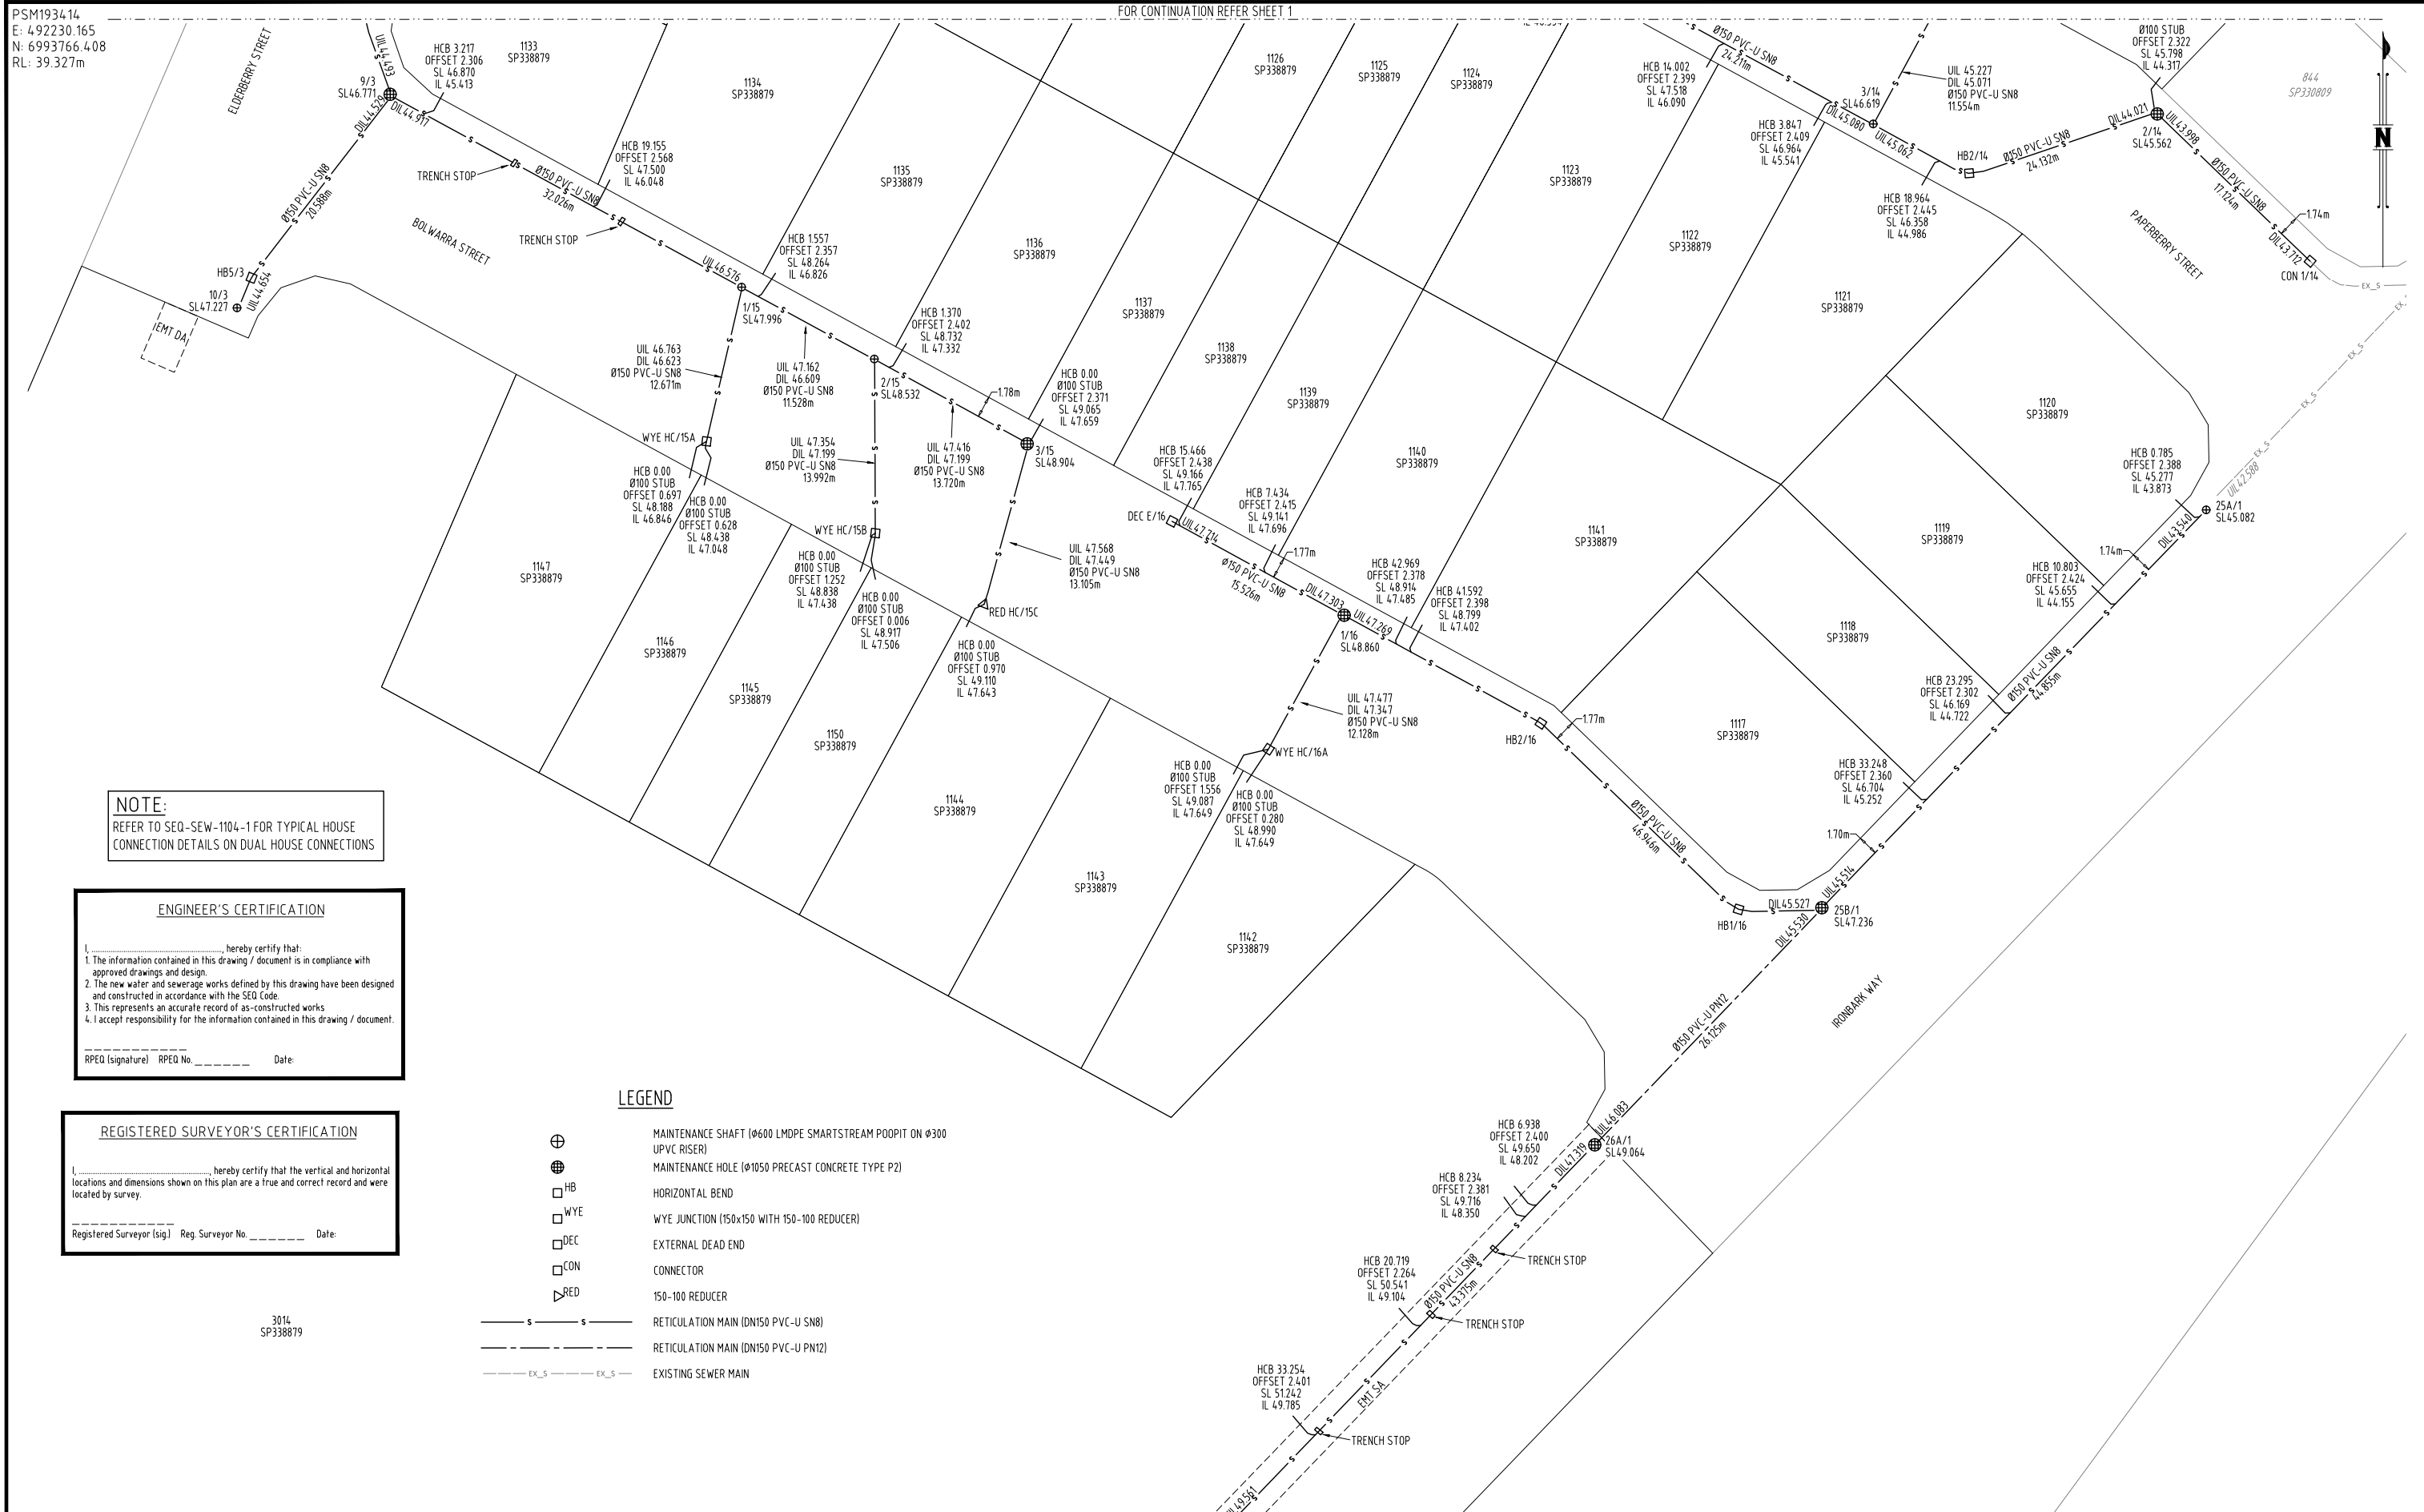

NOTE:
 REFER TO SEQ-SEW-1104-1 FOR TYPICAL HOUSE CONNECTION DETAILS ON DUAL HOUSE CONNECTIONS

ENGINEER'S CERTIFICATION

I, _____, hereby certify that:
 1. The information contained in this drawing / document is in compliance with approved drawings and design.
 2. The new water and sewerage works defined by this drawing have been designed and constructed in accordance with the SEQ Code.
 3. This represents an accurate record of as-constructed works.
 4. I accept responsibility for the information contained in this drawing / document.

RPEQ (signature) RPEQ No. _____ Date: _____

REGISTERED SURVEYOR'S CERTIFICATION

I, _____, hereby certify that the vertical and horizontal locations and dimensions shown on this plan are a true and correct record and were located by survey.


Registered Surveyor (sig.) Reg. Surveyor No. _____ Date: _____

LEGEND

- ⊕ MAINTENANCE SHAFT (Ø600 LMDPE SMARTSTREAM POOPIT ON Ø300 UPVC RISER)
- ⊕ MAINTENANCE HOLE (Ø1050 PRECAST CONCRETE TYPE P2)
- ⊠ HB HORIZONTAL BEND
- ⊠ WYE WYE JUNCTION (150x150 WITH 150-100 REDUCER)
- ⊠ DEC EXTERNAL DEAD END
- ⊠ CON CONNECTOR
- ⊠ RED 150-100 REDUCER
- s — s — RETICULATION MAIN (DN150 PVC-U SN8)
- s — s — RETICULATION MAIN (DN150 PVC-U PN12)
- - - - - EX_S - EX_S - EXISTING SEWER MAIN

3014
 SP338879

COORDINATE DATUM NOTE:
 HORIZONTAL COORDINATES (E,N) SUPPLIED ARE MAPPING GRID OF AUSTRALIA (MGA), ZONE 56 BASED ON THE UNIVERSAL TRANSVERSE MERCATOR PROJECTION AND THE GEOCENTRIC DATUM OF AUSTRALIA 2020.

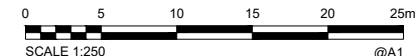

AS CONSTRUCTED

A1	INDEX	DATE	REVISIONS	DRAWN	CHECKED	PASSED	INITIALS	DATE

DRAWN	ARR	31/07/2024
CHECKED	BAS	05/08/2024
PASSED		



LEVEL 2, 1 INNOVATION PARKWAY, BIRTNYA, QLD, 4575
 0754.135300



Unitywater
 2018012748516
 RIDGEVIEW - STAGE 11
 AS CONSTRUCTED
 SEWERAGE RETICULATION

SHEET 4 OF 4 SHEETS	SCALE 1:250
REVISION DATE	REVISION
DISCIPLINE CODE	C
DRAWING NO.	U-2023-5252