


PSM1934.14
 E: 492230.166
 N: 6993766.407
 RL: 39.327m

ENGINEER'S CERTIFICATION
 I, _____, hereby certify that the as-constructed details shown on this drawing are a true and accurate record of the construction works, in compliance with the approved drawings and approved design.
 RPEQ (signature) RPEQ No. _____ Date: _____

REGISTERED SURVEYOR'S CERTIFICATION
 I, Dale Delaforce, hereby certify that the vertical and horizontal locations and dimensions shown on this plan are a true and correct record and were located by survey.
 Registered Surveyor (sig.) Reg. Surveyor No. 6176 Date: 07/05/2025

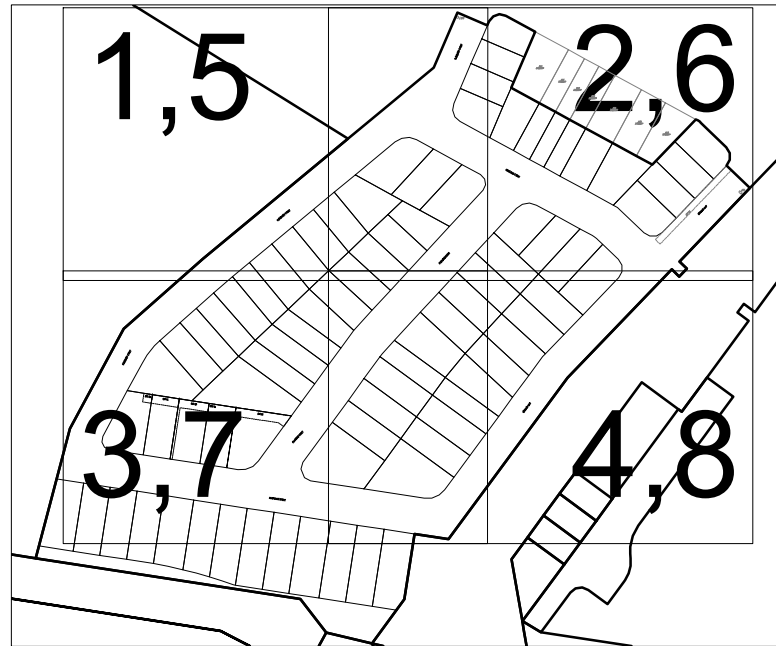


KEYPLAN N.T.S.

NOTE:
 ALL WATER CONNECTIONS AT THE LOT ARE
 Ø25 PE-100 PN16 UNLESS OTHERWISE NOTED

LEGEND

- EX_W — EXISTING WATER MAIN
- W — WATER MAIN (DN100 PVC-D PN16)
- WATER MAIN (DN100 DIOL PN35)
- SERVICE PIPE (ØD25 PE-100 PN16)
- CONDUIT PIPE (DN100 PVC-U PN9)
- WM WATER METER - 20mm ITRON
- | FH FIRE HYDRANT
- TEE
- RT READY TAP
- BEND
- DEC END CAP
- ✕ SV STOP VALVE

COORDINATE DATUM NOTE:
 HORIZONTAL COORDINATES (E,N) SUPPLIED ARE MAPPING GRID OF AUSTRALIA (MGA), ZONE 56 BASED ON THE UNIVERSAL TRANSVERSE MERCATOR PROJECTION AND THE GEOCENTRIC DATUM OF AUSTRALIA 2020.

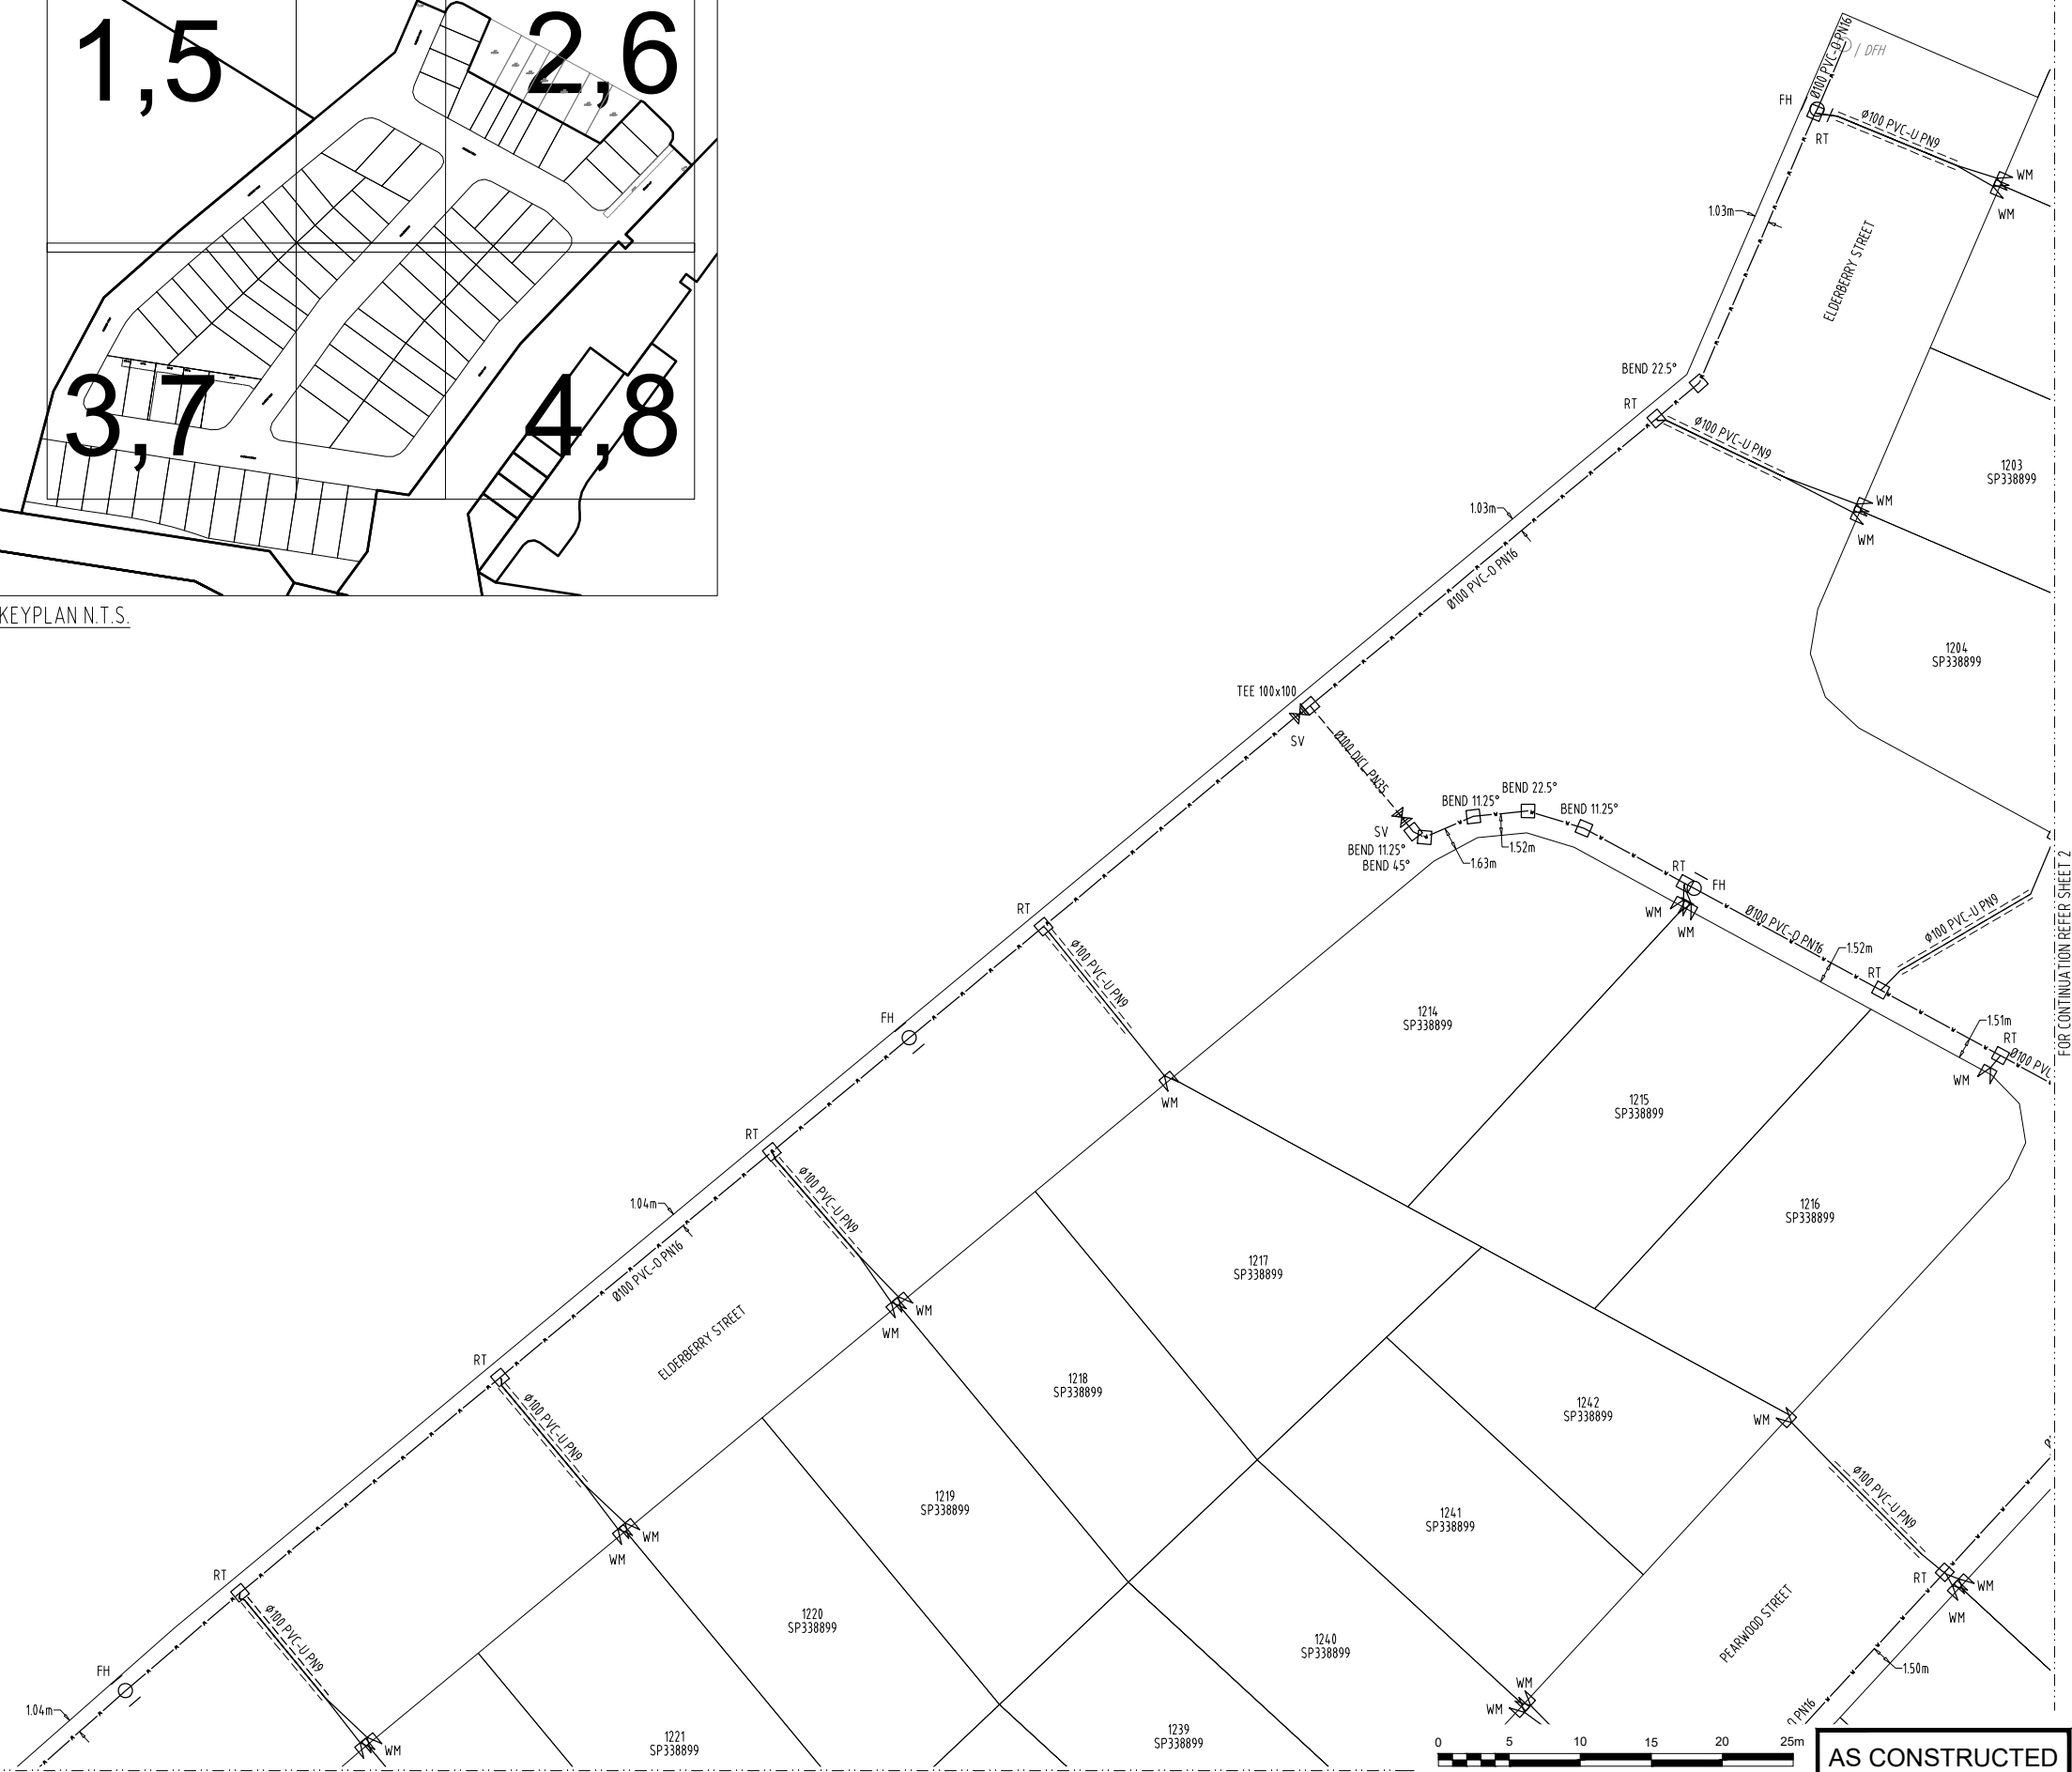

FOR CONTINUATION REFER SHEET 2

A1	0	07/05/2025	AS CONSTRUCTED DETAILS	RMP	BAS	PASSED
	INDEX	DATE	REVISIONS	DRAWN	CHECKED	PASSED

DRAWN	RMP	07/05/2025
CHECKED	BAS	07/05/2025
PASSED		
INITIALS	DATE	



Unitywater
 2018012748517
 2018012748517 - RIDGEVIEW STAGE 12A, 12B, 12C
 AS-CONSTRUCTED WATER SUPPLY

SHEET 1 OF 8 SHEETS	SCALE 1:250
REVISION DATE 27-06-2024	REVISION
DISCIPLINE CODE C	
DRAWING NO. U-2024-5413	

AS CONSTRUCTED

PSM1934.14
 E: 492230.166
 N: 6993766.407
 RL: 39.327m

ENGINEER'S CERTIFICATION
 I, _____, hereby certify that the as-constructed details shown on this drawing are a true and accurate record of the construction works, in compliance with the approved drawings and approved design.
 RPEQ (signature) RPEQ No. _____ Date: _____

REGISTERED SURVEYOR'S CERTIFICATION
 I, Dale Delaforce, hereby certify that the vertical and horizontal locations and dimensions shown on this plan are a true and correct record and were located by survey.
 Registered Surveyor (sig.) Reg. Surveyor No. 6176 Date: 07/05/2025

LEGEND



- EX_W --- EXISTING WATER MAIN
- W — WATER MAIN (DN100 PVC-U PN16)
- - - WATER MAIN (DN100 DICL PN35)
- SP — SERVICE PIPE (OD25 PE-100 PN16)
- - - CONDUIT PIPE (DN100 PVC-U PN9)
- WM WATER METER - 20mm ITRON
- FH FIRE HYDRANT
- TEE TEE
- RT READY TAP
- BEND BEND
- DEC END CAP
- SV STOP VALVE

NOTE:
 ALL WATER CONNECTIONS AT THE LOT ARE
 Ø25 PE-100 PN16 UNLESS OTHERWISE NOTED



FOR CONTINUATION REFER SHEET 1

COORDINATE DATUM NOTE:
 HORIZONTAL COORDINATES (E, N) SUPPLIED ARE MAPPING GRID OF AUSTRALIA (MGA), ZONE 56 BASED ON THE UNIVERSAL TRANSVERSE MERCATOR PROJECTION AND THE GEOCENTRIC DATUM OF AUSTRALIA 2020.

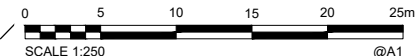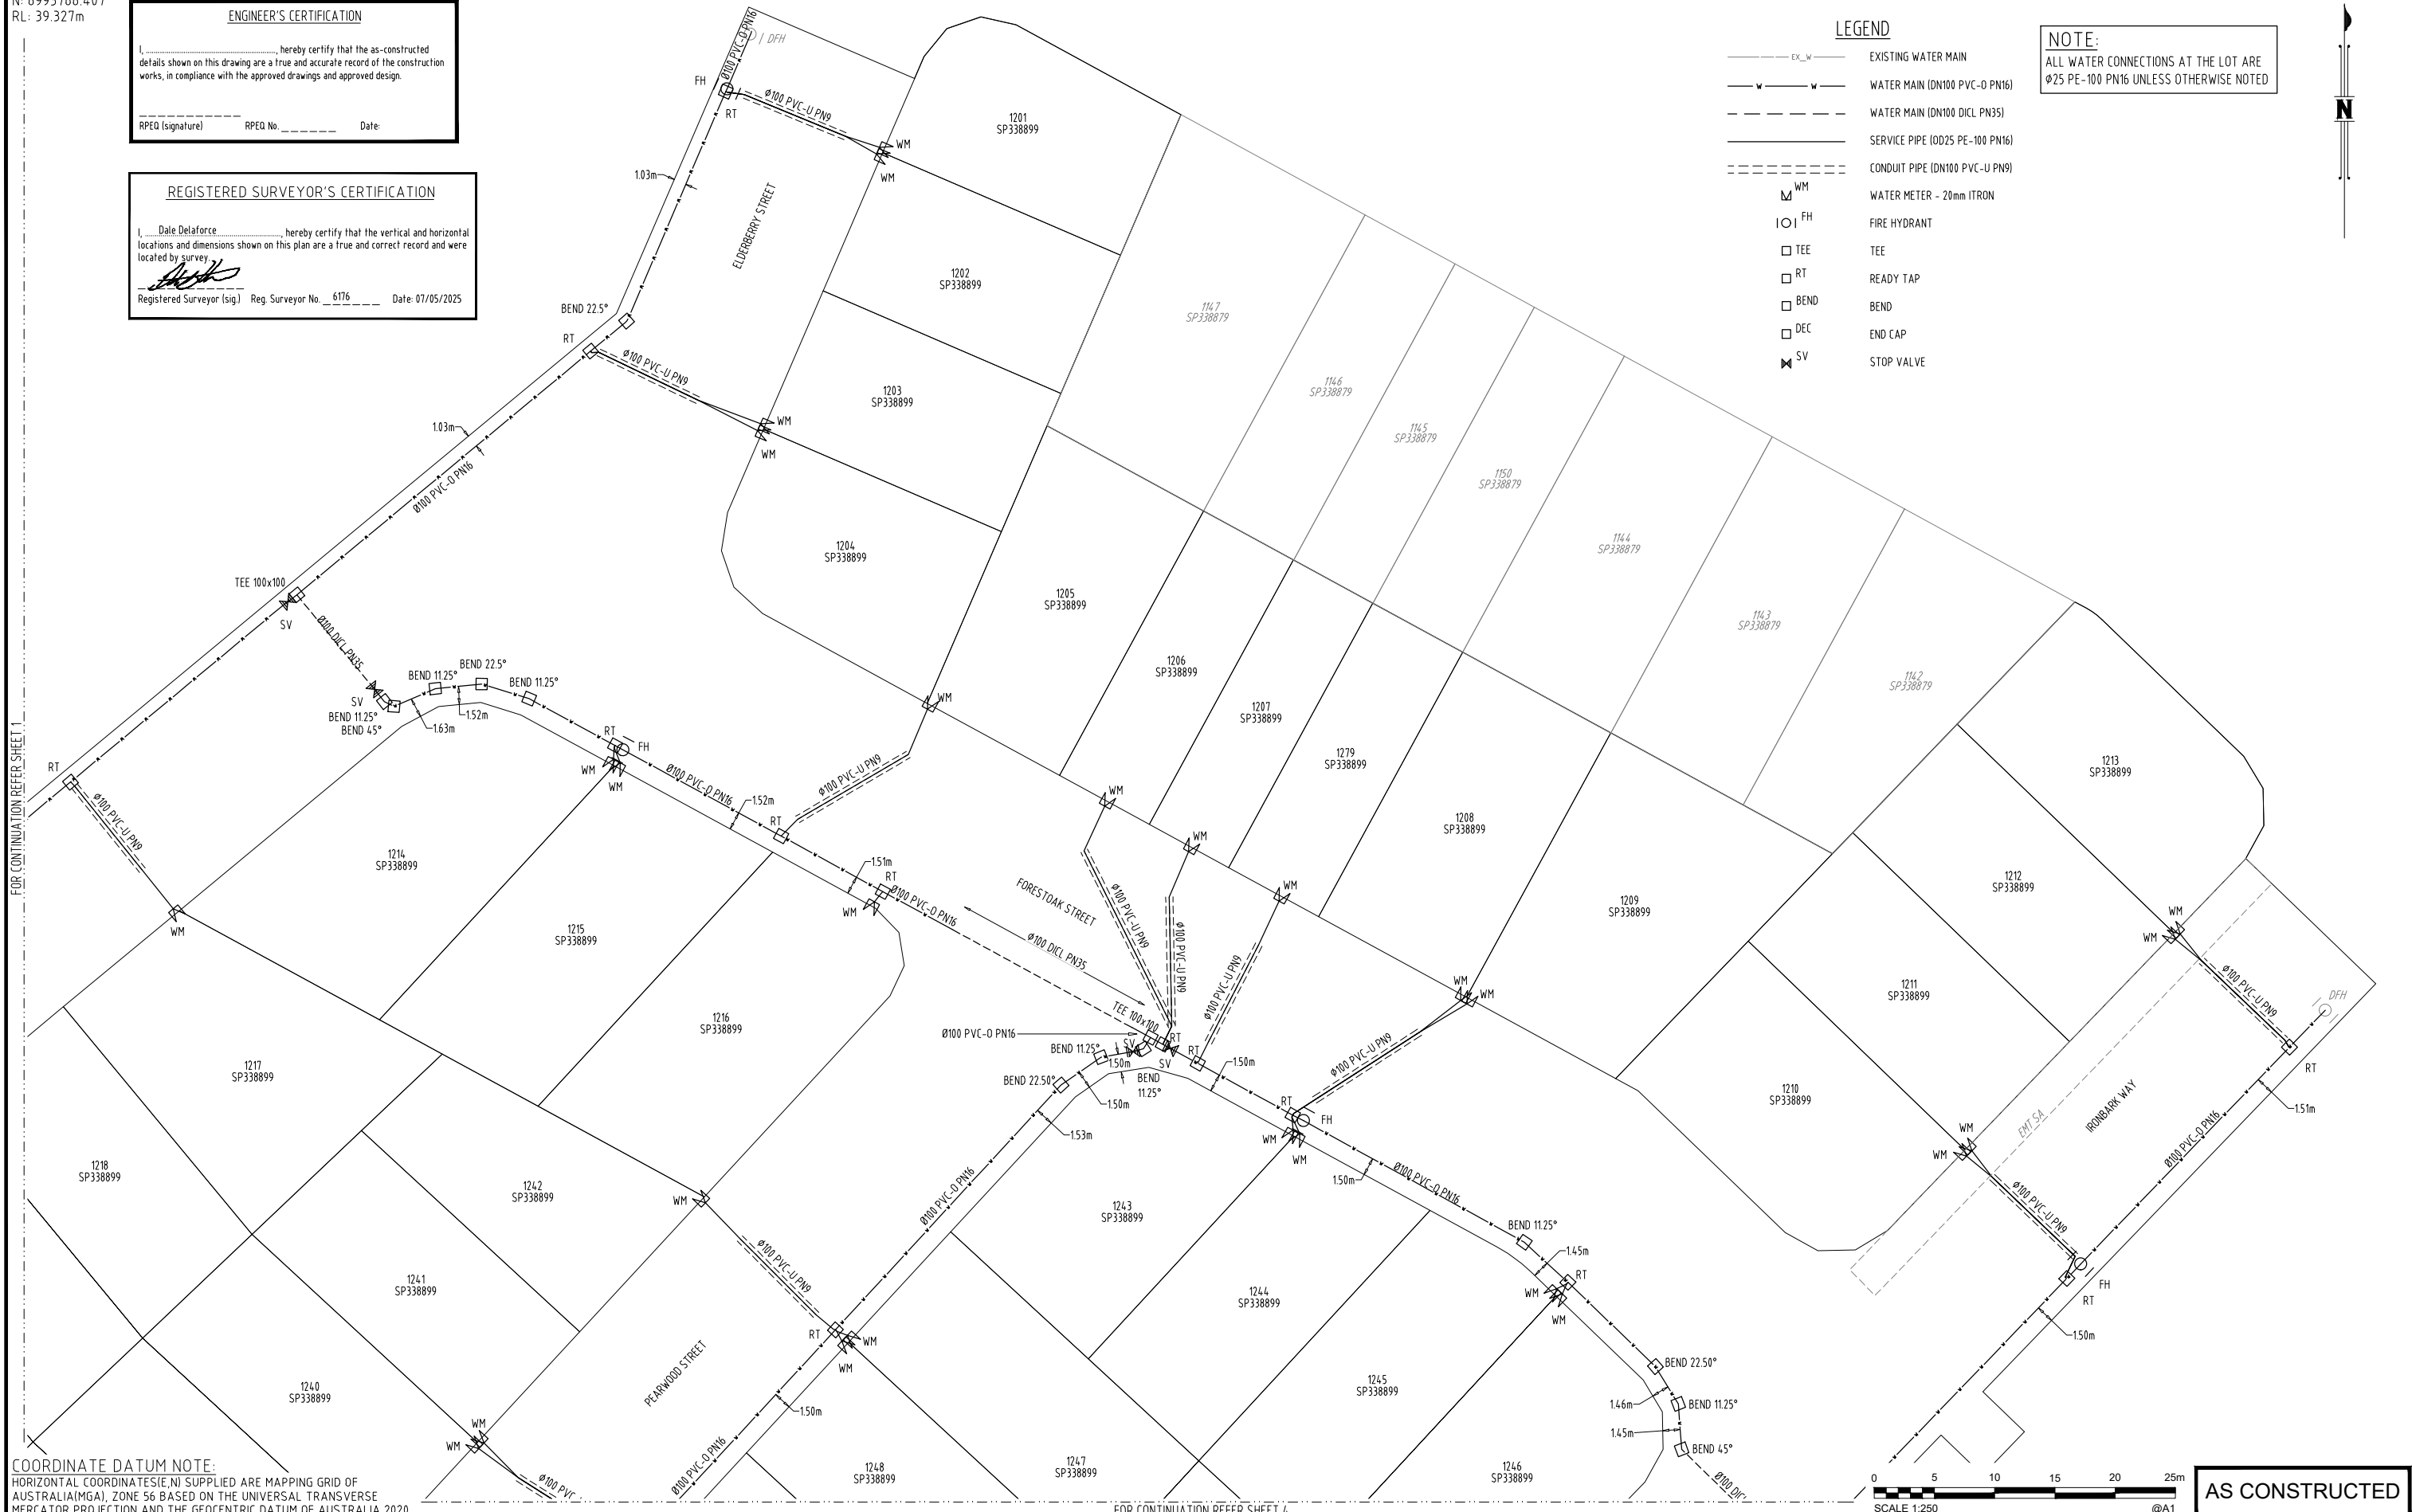

AS CONSTRUCTED

FOR CONTINUATION REFER SHEET 4

A1	0	07/05/2025	AS CONSTRUCTED DETAILS	RMP	BAS	PASSED
	INDEX	DATE	REVISIONS	DRAWN	CHECKED	PASSED

DRAWN	RMP	07/05/2025
CHECKED	BAS	07/05/2025
PASSED		
INITIALS	DATE	

Colliers
 PREPARED BY LION SYSTEMS OPERATIONS




Unitywater
 2018012748517
 2018012748517 - RIDGEVIEW STAGE 12A, 12B, 12C
 AS-CONSTRUCTED WATER SUPPLY

SHEET 2 OF 8 SHEETS	SCALE 1:250
REVISION DATE 27-06-2024	REVISION
DISCIPLINE CODE C	
DRAWING NO. U-2024-5413	

PSM1934.14
 E: 492230.166
 N: 6993766.407
 RL: 39.327m

FOR CONTINUATION REFER SHEET 1

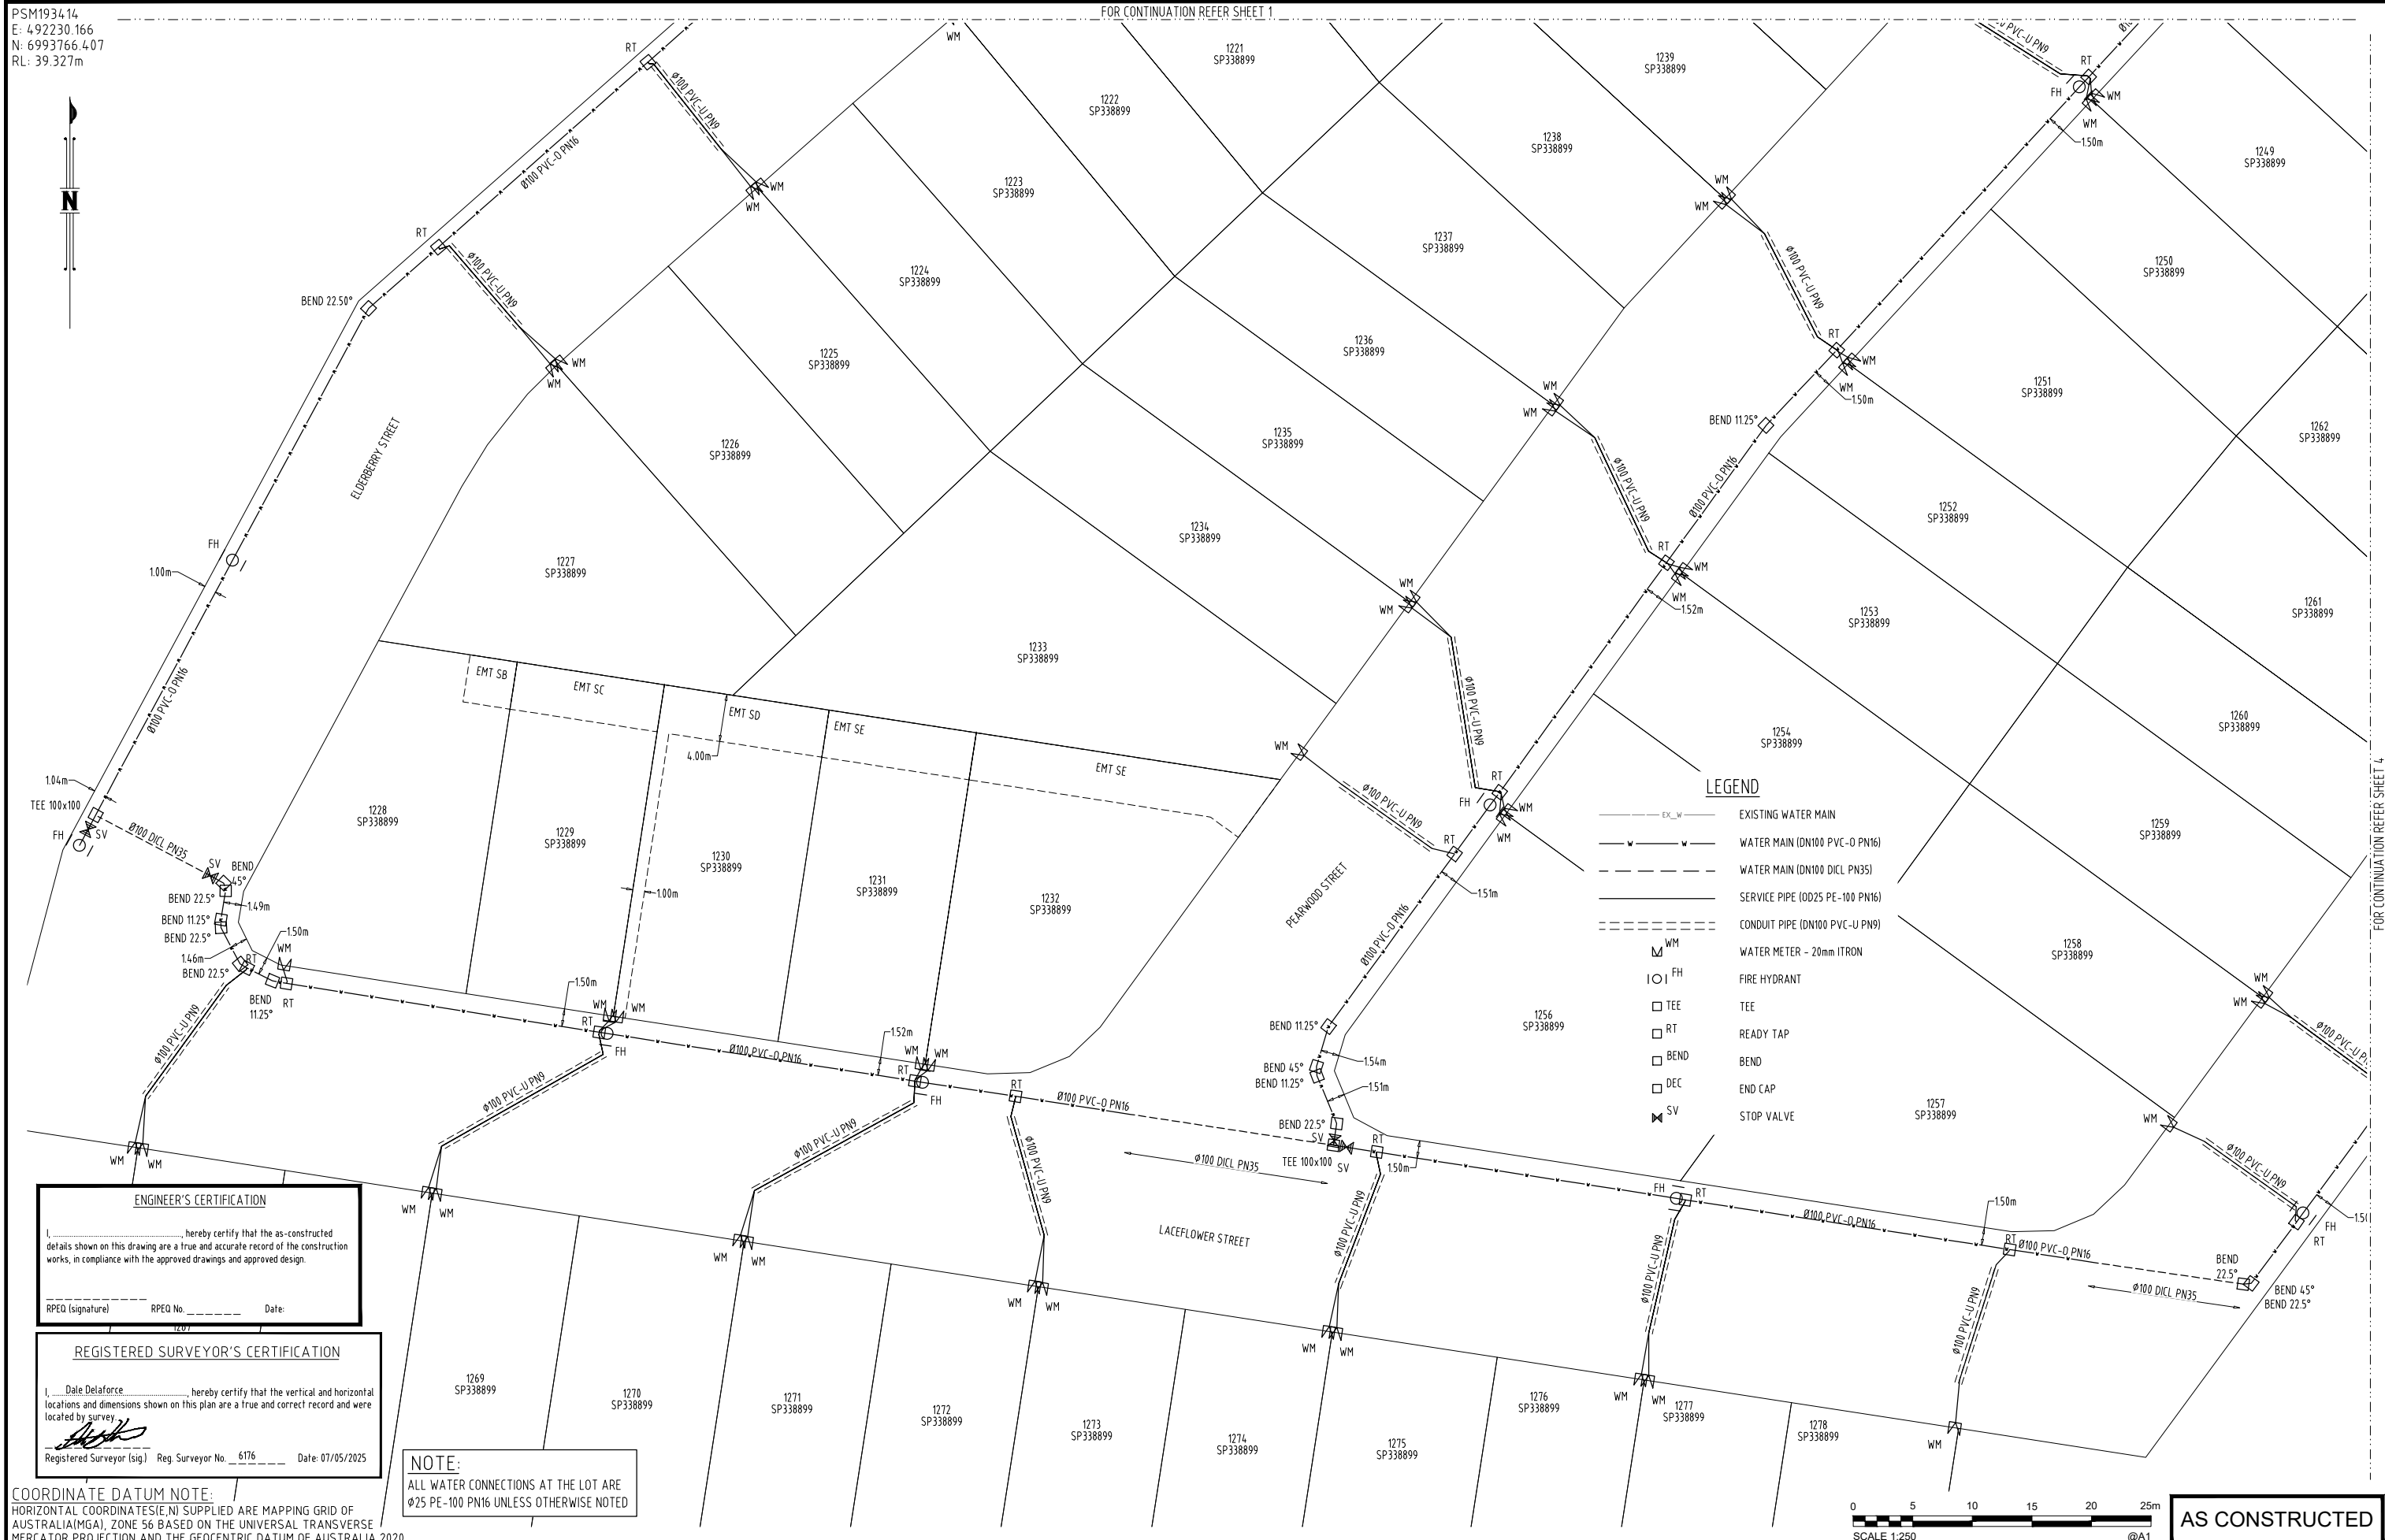

LEGEND

- EX. W — EXISTING WATER MAIN
- - - WATER MAIN (DN100 PVC-U PN16)
- - - WATER MAIN (DN100 DI CL PN35)
- · · SERVICE PIPE (DN25 PE-100 PN16)
- - - CONDUIT PIPE (DN100 PVC-U PN9)
- WM WATER METER - 20mm ITRON
- FH FIRE HYDRANT
- TEE TEE
- RT READY TAP
- BEND BEND
- DEC END CAP
- SV STOP VALVE

ENGINEER'S CERTIFICATION
 I, _____, hereby certify that the as-constructed details shown on this drawing are a true and accurate record of the construction works, in compliance with the approved drawings and approved design.
 RPEQ (Signature) RPEQ No. _____ Date: _____

REGISTERED SURVEYOR'S CERTIFICATION
 I, _____ Date Delaforce _____ hereby certify that the vertical and horizontal locations and dimensions shown on this plan are a true and correct record and were located by survey.
 Registered Surveyor (sig) Reg. Surveyor No. 6176 Date: 07/05/2025

NOTE:
 ALL WATER CONNECTIONS AT THE LOT ARE Ø25 PE-100 PN16 UNLESS OTHERWISE NOTED

COORDINATE DATUM NOTE:
 HORIZONTAL COORDINATE(S) SUPPLIED ARE MAPPING GRID OF AUSTRALIA(MGA), ZONE 56 BASED ON THE UNIVERSAL TRANSVERSE MERCATOR PROJECTION AND THE GEOCENTRIC DATUM OF AUSTRALIA 2020.



AS CONSTRUCTED

A1	0	07/05/2025	AS CONSTRUCTED DETAILS	RMP	BAS	PASSED		
	INDEX	DATE	REVISIONS	DRAWN	CHECKED	PASSED	INITIALS	DATE


 PREPARED BY LION SYSTEMS OPERATIONS




Unitywater

2018012748517
 2018012748517 - RIDGEVIEW STAGE 12A, 12B, 12C
 AS-CONSTRUCTED WATER SUPPLY

SHEET 3 OF 8 SHEETS	SCALE 1:250
REVISION DATE 27-06-2024	REVISION
DISCIPLINE CODE C	
DRAWING NO. U-2024-5413	

PSM1934.14
 E: 492230.166
 N: 6993766.407
 RL: 39.327m

FOR CONTINUATION REFER SHEET 2

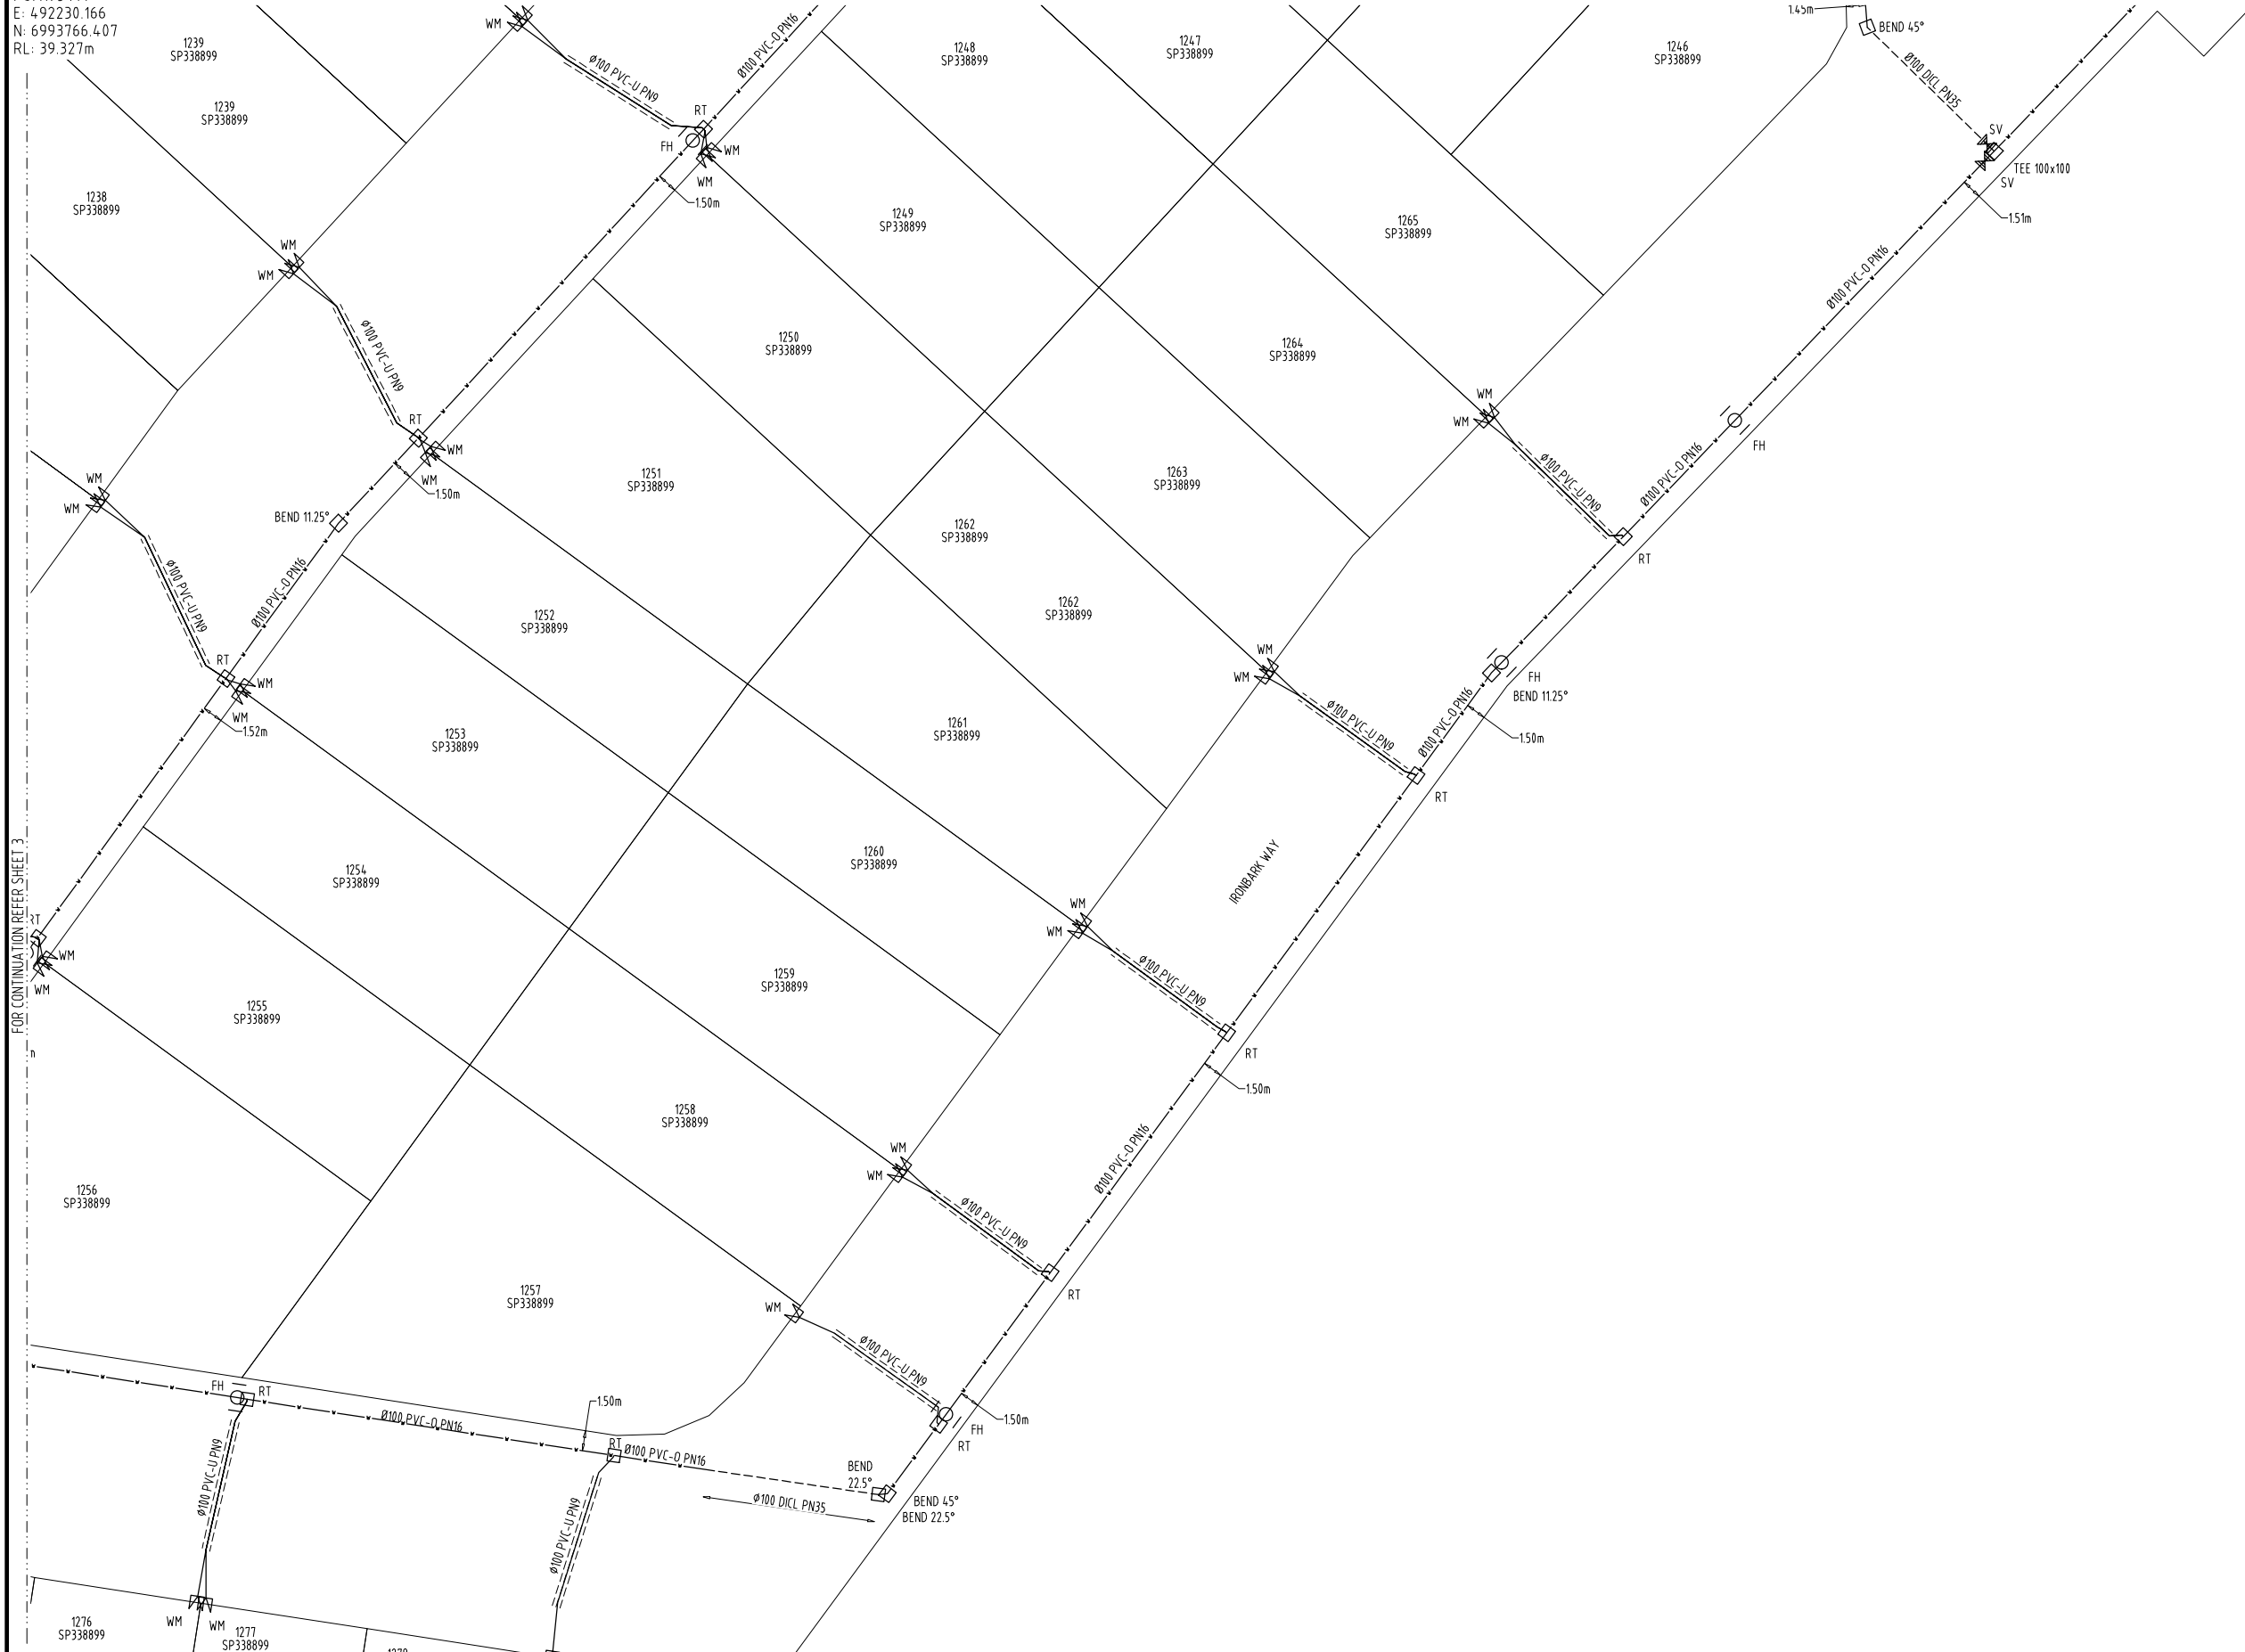

LEGEND


- EX_W — EXISTING WATER MAIN
- W — WATER MAIN (DN100 PVC-U PN16)
- W — WATER MAIN (DN100 DICT PN35)
- S — SERVICE PIPE (OD25 PE-100 PN16)
- C — CONDUIT PIPE (DN100 PVC-U PN9)
- WM WATER METER - 20mm ITRON
- FH FIRE HYDRANT
- TEE TEE
- RT READY TAP
- BEND BEND
- DEC END CAP
- SV STOP VALVE

NOTE:
 ALL WATER CONNECTIONS AT THE LOT ARE
 $\phi 25$ PE-100 PN16 UNLESS OTHERWISE NOTED

ENGINEER'S CERTIFICATION
 I, _____, hereby certify that the as-constructed details shown on this drawing are a true and accurate record of the construction works, in compliance with the approved drawings and approved design.
 RPEQ (signature) RPEQ No. _____ Date: _____

REGISTERED SURVEYOR'S CERTIFICATION
 I, Dale DeLaforce, hereby certify that the vertical and horizontal locations and dimensions shown on this plan are a true and correct record and were located by survey.
 Registered Surveyor (sig) Reg. Surveyor No. 6176 Date: 07/05/2025

COORDINATE DATUM NOTE:
 HORIZONTAL COORDINATES (N) SUPPLIED ARE MAPPING GRID OF AUSTRALIA (MGA), ZONE 56 BASED ON THE UNIVERSAL TRANSVERSE MERCATOR PROJECTION AND THE GEOCENTRIC DATUM OF AUSTRALIA 2020.

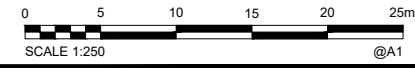

AS CONSTRUCTED

A1	0	07/05/2025	AS CONSTRUCTED DETAILS	RMP	BAS	PASSED		
	INDEX	DATE	REVISIONS	DRAWN	CHECKED	PASSED	INITIALS	DATE

DRAWN	RMP	07/05/2025
CHECKED	BAS	07/05/2025
PASSED		

PREPARED BY LION SYSTEMS OPERATIONS

Unitywater

2018012748517
 2018012748517 - RIDGEVIEW STAGE 12A, 12B, 12C
 AS-CONSTRUCTED WATER SUPPLY

SHEET 4 OF 8 SHEETS	SCALE 1:250
REVISION DATE 27-06-2024	REVISION
DISCIPLINE CODE C	
DRAWING NO. U-2024-5413	

PSM1934.14
 E: 492230.166
 N: 6993766.407
 RL: 39.327m

ENGINEER'S CERTIFICATION
 I, _____, hereby certify that the as-constructed details shown on this drawing are a true and accurate record of the construction works, in compliance with the approved drawings and approved design.
 RPEQ (signature) RPEQ No. _____ Date: _____

REGISTERED SURVEYOR'S CERTIFICATION
 I, Dale Delaforce, hereby certify that the vertical and horizontal locations and dimensions shown on this plan are a true and correct record and were located by survey.
 Registered Surveyor (sig.) Reg. Surveyor No. 6176 Date: 07/05/2025



LEGEND

- ⊕ MAINTENANCE SHAFT (Ø600 LMDPE SMARTSTREAM POOPIT ON Ø300 UPVC RISER)
- ⊗ MAINTENANCE HOLE (Ø1050 PRECAST CONCRETE TYPE P2)
- HB HORIZONTAL BEND
- WYE WYE JUNCTION (150x150 WITH 150-100 REDUCER)
- DEC EXTERNAL DEAD END
- CON CONNECTOR
- RED 150-100 REDUCER
- s — s — RETICULATION MAIN (DN150 PVC-U SN8)
- s — s — RETICULATION MAIN (DN150 PVC-U PN12)
- EX_S — EX_S — EXISTING SEWER MAIN

NOTE:
 REFER TO SEQ-SEW-1104-1 FOR TYPICAL HOUSE CONNECTION DETAILS ON DUAL HOUSE CONNECTIONS

COORDINATE DATUM NOTE:
 HORIZONTAL COORDINATES (E, N) SUPPLIED ARE MAPPING GRID OF AUSTRALIA (MGA), ZONE 56 BASED ON THE UNIVERSAL TRANSVERSE MERCATOR PROJECTION AND THE GEOCENTRIC DATUM OF AUSTRALIA 2020.



0 5 10 15 20 25m
 SCALE 1:250 @A1

AS CONSTRUCTED

A1	0	07/05/2025	AS CONSTRUCTED DETAILS	RMP	BAS	PASSED		
	INDEX	DATE	REVISIONS	DRAWN	CHECKED	PASSED	INITIALS	DATE

DRAWN	RMP	07/05/2025
CHECKED	BAS	07/05/2025
PASSED		


 PREPARED BY LION SYSTEMS OPERATIONS


 UNITY WATER

Unitywater
 2018012748517
 2018012748517 - RIDGEVIEW STAGE 12A, 12B, 12C
 AS-CONSTRUCTED SEWER RETICULATION

SHEET 5 OF 8 SHEETS	SCALE 1:250
REVISION DATE 27-06-2024	REVISION
DISCIPLINE CODE C	
DRAWING NO. U-2024-5413	

PSM1934.14
 E: 492230.166
 N: 6993766.407
 RL: 39.327m

ENGINEER'S CERTIFICATION
 I, _____, hereby certify that the as-constructed details shown on this drawing are a true and accurate record of the construction works, in compliance with the approved drawings and approved design.
 RPEQ (signature) RPEQ No. _____ Date: _____


REGISTERED SURVEYOR'S CERTIFICATION
 I, Dale Delaforce, hereby certify that the vertical and horizontal locations and dimensions shown on this plan are a true and correct record and were located by survey.
 Registered Surveyor (sig.) Reg. Surveyor No. 6176 Date: 07/05/2025

LEGEND


- ⊕ MAINTENANCE SHAFT (Ø600 LMDPE SMARTSTREAM POOPIT ON Ø300 UPVC RISER)
- ⊕ MAINTENANCE HOLE (Ø1050 PRECAST CONCRETE TYPE P2)
- HB HORIZONTAL BEND
- WYE WYE JUNCTION (150x150 WITH 150-100 REDUCER)
- DEC EXTERNAL DEAD END
- CON CONNECTOR
- ▷ RED 150-100 REDUCER
- s — s — RETICULATION MAIN (DN150 PVC-U SN8)
- s — s — RETICULATION MAIN (DN150 PVC-U PN12)
- - - - - EX_S - - - - - EX_S - - - - - EXISTING SEWER MAIN

NOTE:
 REFER TO SEQ-SEW-1104-1 FOR TYPICAL HOUSE CONNECTION DETAILS ON DUAL HOUSE CONNECTIONS

FOR CONTINUATION REFER SHEET 5

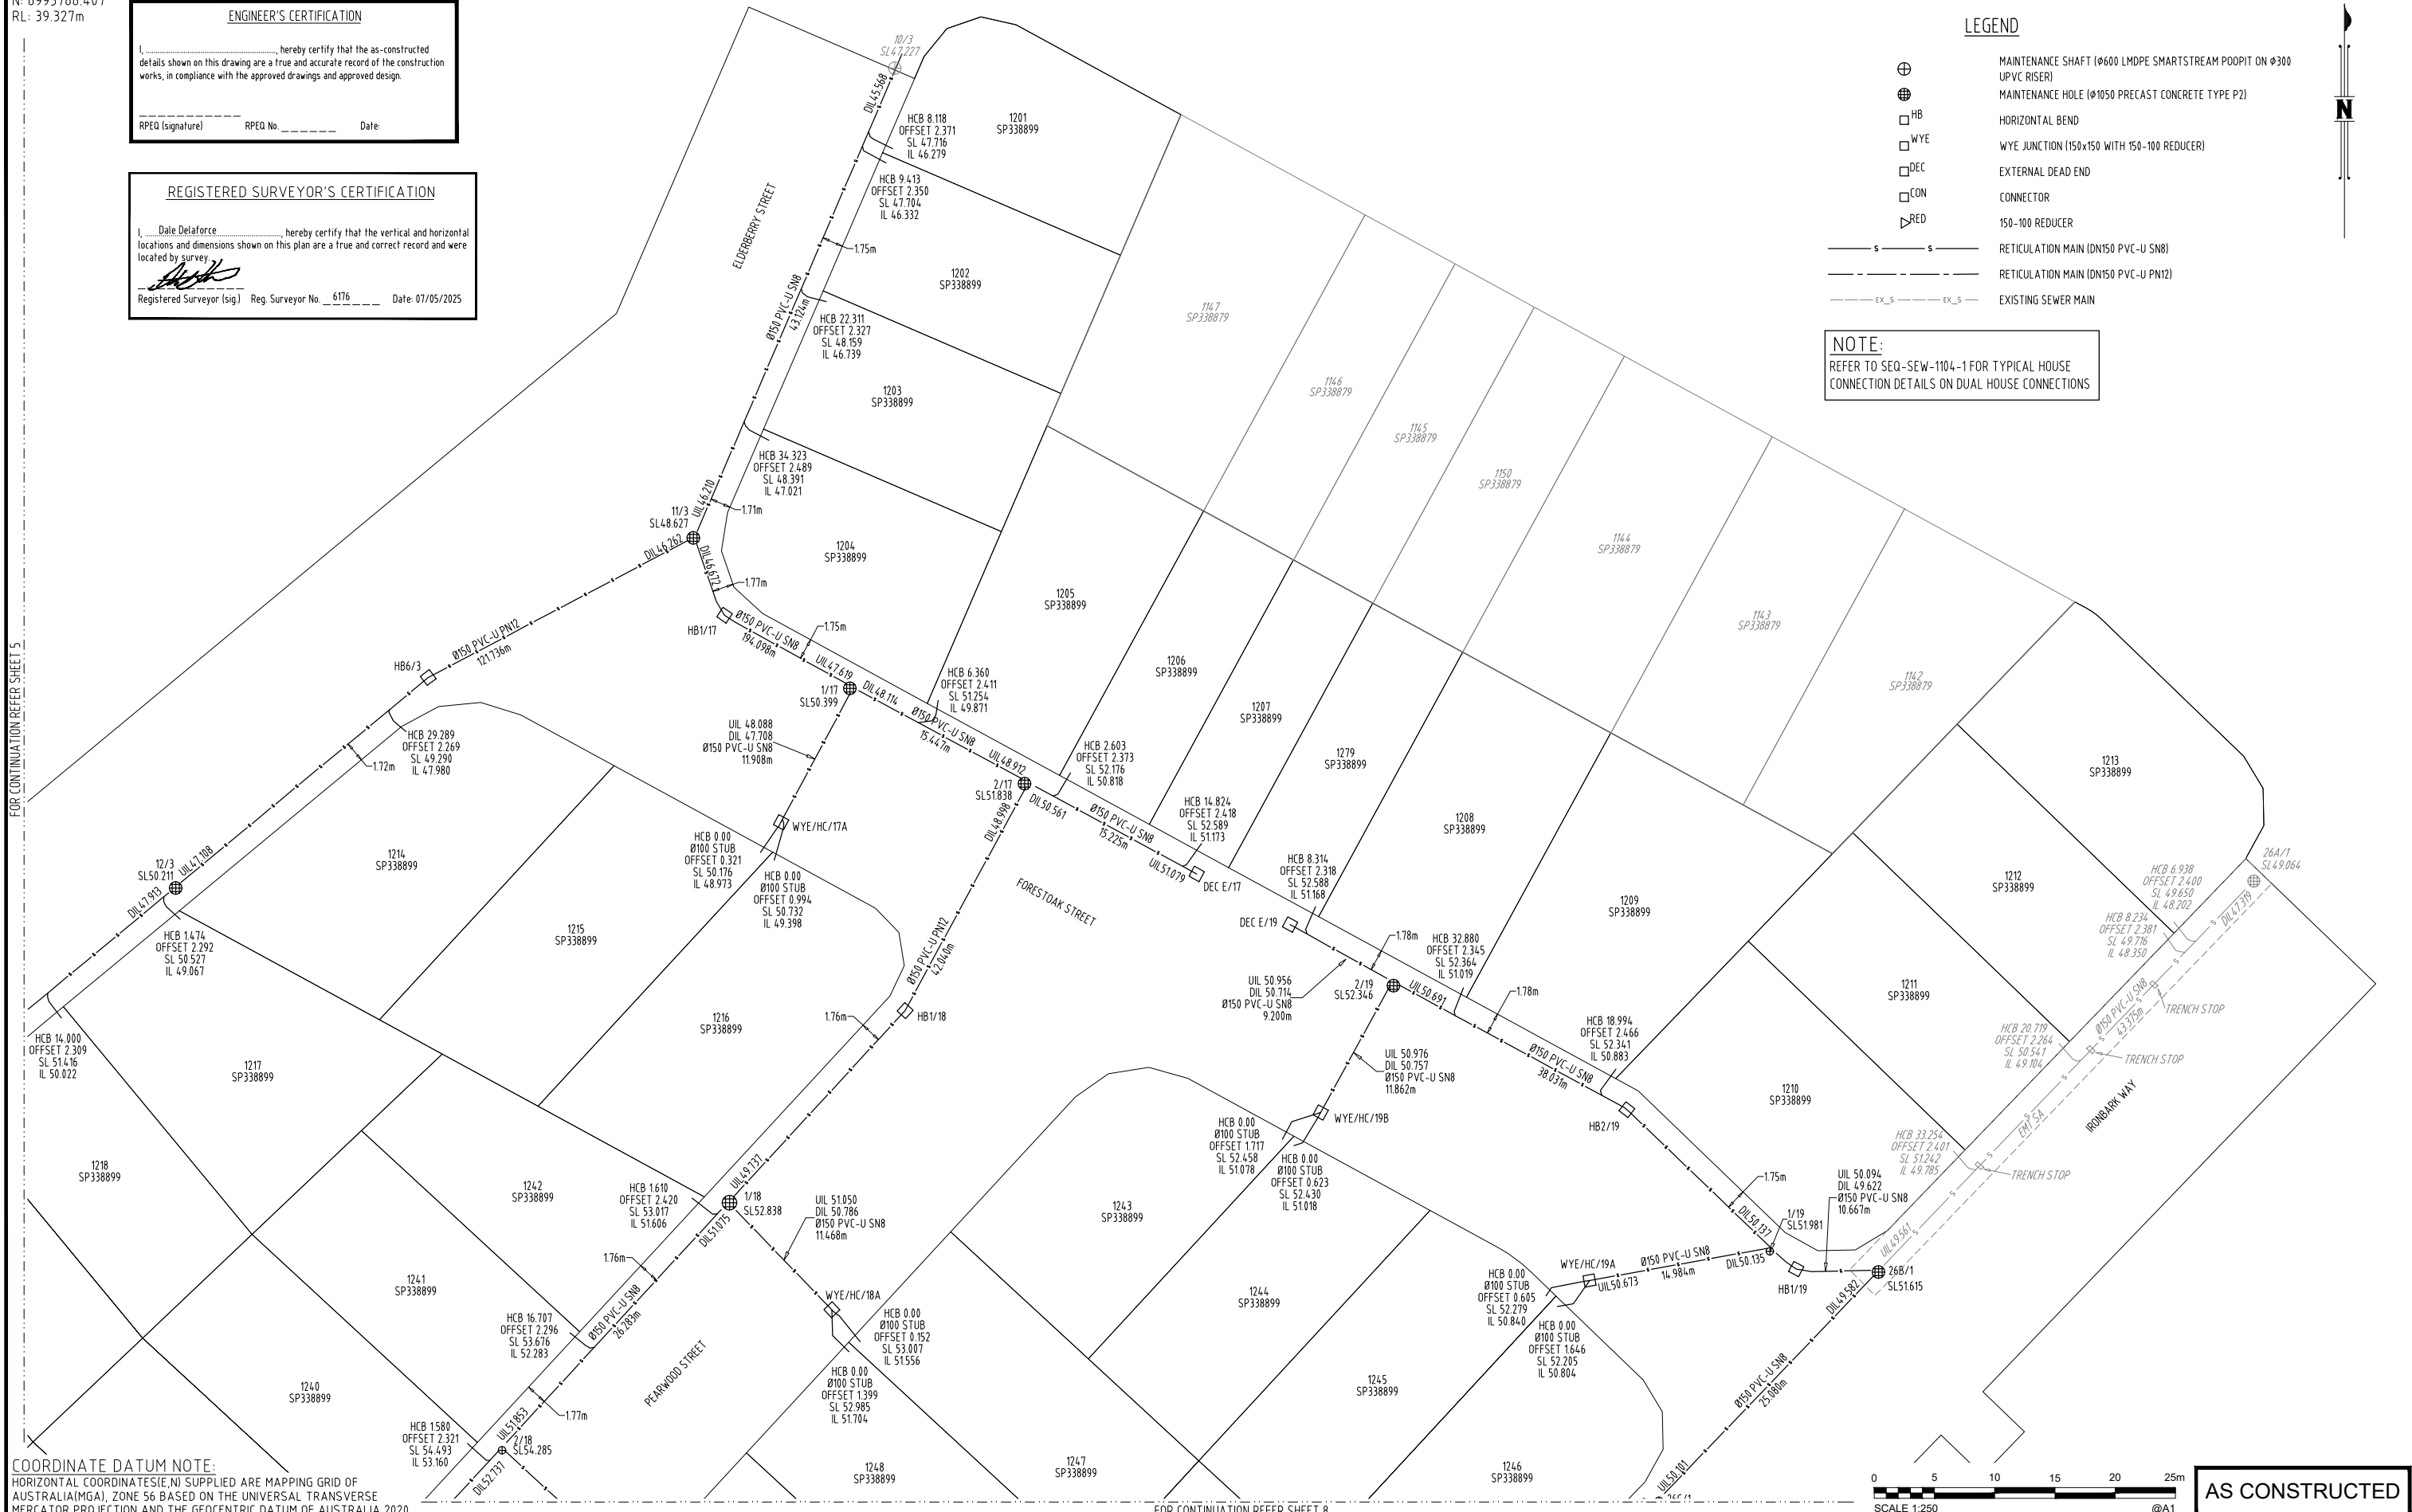

COORDINATE DATUM NOTE:
 HORIZONTAL COORDINATES (E, N) SUPPLIED ARE MAPPING GRID OF AUSTRALIA (MGA), ZONE 56 BASED ON THE UNIVERSAL TRANSVERSE MERCATOR PROJECTION AND THE GEOCENTRIC DATUM OF AUSTRALIA 2020.

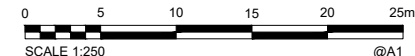

AS CONSTRUCTED

FOR CONTINUATION REFER SHEET 8

A1	0	07/05/2025	AS CONSTRUCTED DETAILS	RMP	BAS	
	INDEX	DATE	REVISIONS	DRAWN	CHECKED	PASSED

DRAWN	RMP	07/05/2025
CHECKED	BAS	07/05/2025
PASSED		
INITIALS	DATE	



Unitywater
 2018012748517
 2018012748517 - RIDGEVIEW STAGE 12A, 12B, 12C
 AS-CONSTRUCTED SEWER RETICULATION

SHEET 6 OF 8 SHEETS	SCALE 1:250
REVISION DATE 27-06-2024	REVISION
DISCIPLINE CODE C	
DRAWING NO. U-2024-5413	

PSM1934.14
 E: 492230.166
 N: 6993766.407
 RL: 39.327m

FOR CONTINUATION REFER SHEET 5


LEGEND

- MAINTENANCE SHAFT (Ø600 LMDPE SMARTSTREAM POOPIT ON Ø300 UPVC RISER)
- MAINTENANCE HOLE (Ø150 PRECAST CONCRETE TYPE P2)
- HORIZONTAL BEND
- WYE JUNCTION (150x150 WITH 150-100 REDUCER)
- EXTERNAL DEAD END
- CONNECTOR
- 150-100 REDUCER
- RETICULATION MAIN (DN150 PVC-U SN8)
- RETICULATION MAIN (DN150 PVC-U PN12)
- EXISTING SEWER MAIN


NOTE:
 ALL WATER CONNECTIONS AT THE LOT ARE
 Ø25 PE-100 PN16 UNLESS OTHERWISE NOTED

ENGINEER'S CERTIFICATION
 I, _____, hereby certify that the as-constructed details shown on this drawing are a true and accurate record of the construction works, in compliance with the approved drawings and approved design.
 RPEO (signature) RPEO No. _____ Date: _____

REGISTERED SURVEYOR'S CERTIFICATION
 I, Dale Delaforce, hereby certify that the vertical and horizontal locations and dimensions shown on this plan are a true and correct record and were located by survey.
 Registered Surveyor (sig.) Reg. Surveyor No. 6176 Date: 07/05/2025

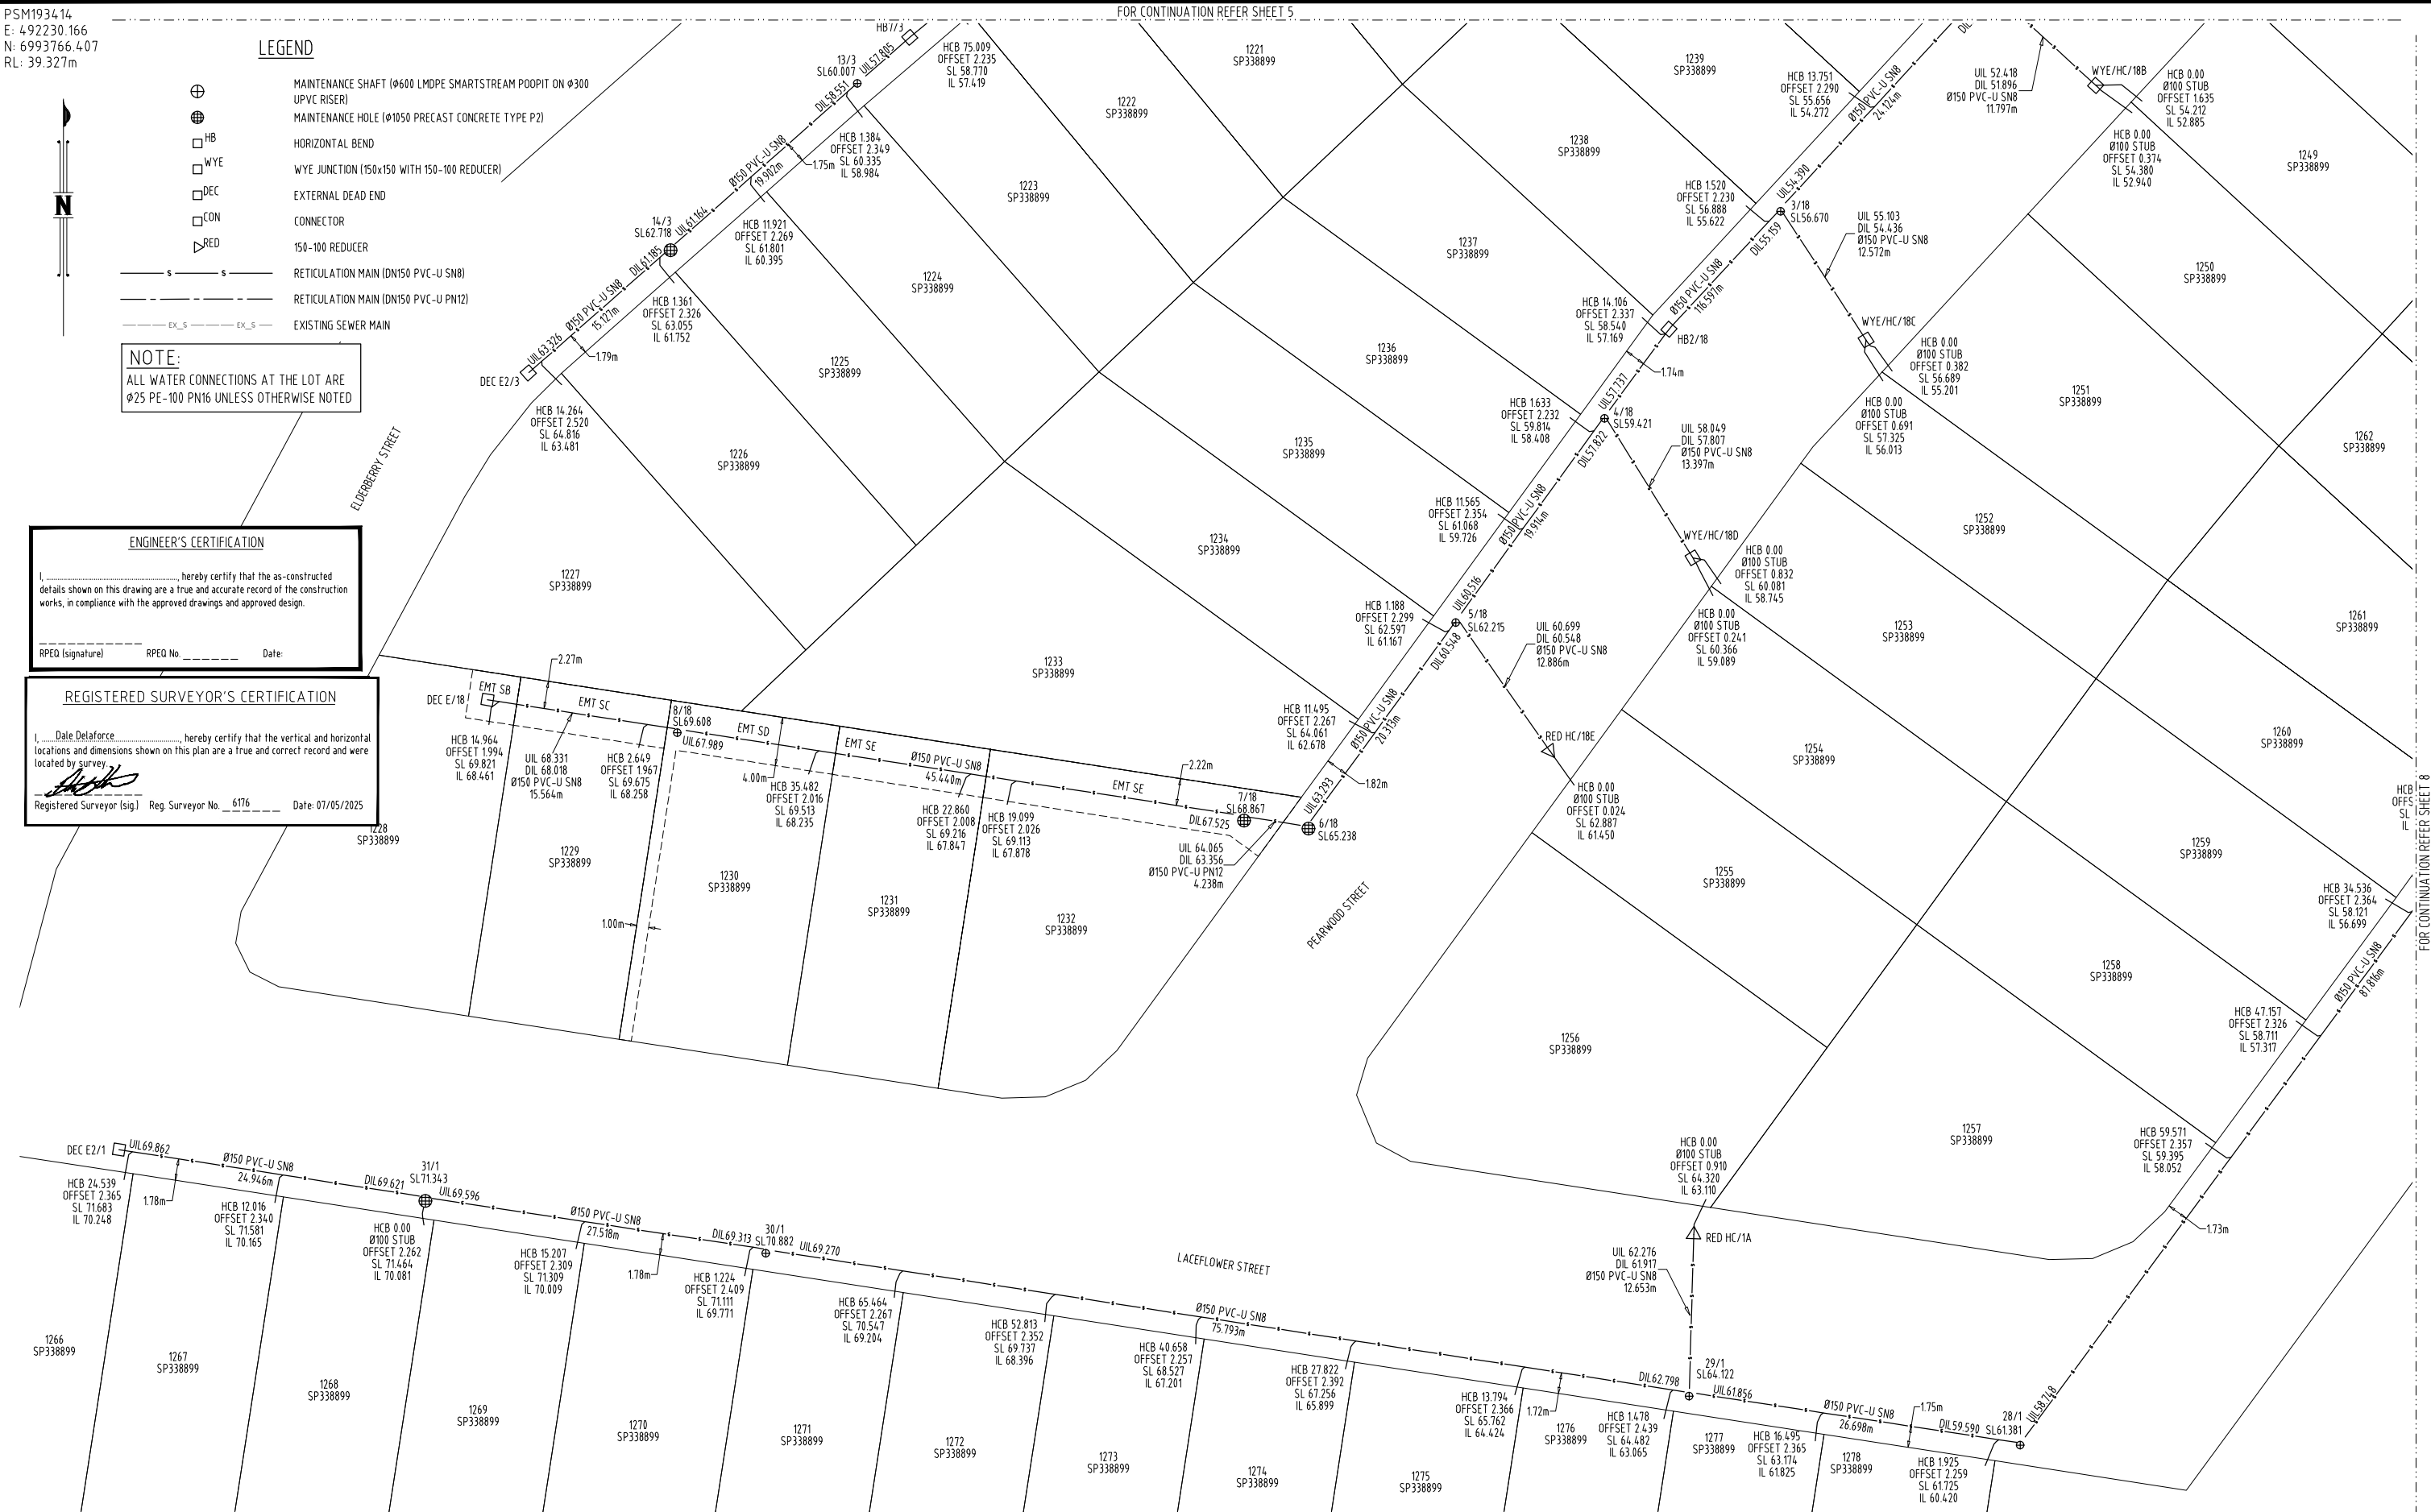

COORDINATE DATUM NOTE:
 HORIZONTAL COORDINATES (E, N) SUPPLIED ARE MAPPING GRID OF AUSTRALIA (MGA), ZONE 56 BASED ON THE UNIVERSAL TRANSVERSE MERCATOR PROJECTION AND THE GEOCENTRIC DATUM OF AUSTRALIA 2020.

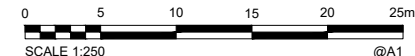

AS CONSTRUCTED

A1	0	07/05/2025	AS CONSTRUCTED DETAILS	RMP	BAS	PASSED		
	INDEX	DATE	REVISIONS	DRAWN	CHECKED	PASSED	INITIALS	DATE

PREPARED BY LION SYSTEMS OPERATIONS

Unitywater

2018012748517
 2018012748517 - RIDGEVIEW STAGE 12A, 12B, 12C
 AS-CONSTRUCTED SEWER RETICULATION

SHEET 7 OF 8 SHEETS	SCALE 1:250
REVISION DATE 27-06-2024	REVISION
DISCIPLINE CODE C	
DRAWING NO. U-2024-5413	

PSM1934.14
 E: 492230.166
 N: 6993766.407
 RL: 39.327m

FOR CONTINUATION REFER SHEET 6



LEGEND

- MAINTENANCE SHAFT (Ø600 LMDPE SMARTSTREAM POOPIT ON Ø300 UPVC RISER)
- MAINTENANCE HOLE (Ø1050 PRECAST CONCRETE TYPE P2)
- HORIZONTAL BEND
- WYE JUNCTION (150x150 WITH 150-100 REDUCER)
- EXTERNAL DEAD END
- CONNECTOR
- 150-100 REDUCER
- RETICULATION MAIN (DN150 PVC-U SN8)
- RETICULATION MAIN (DN150 PVC-U PN12)
- EXISTING SEWER MAIN

NOTE:
 REFER TO SEQ-SEW-1104-1 FOR TYPICAL HOUSE CONNECTION DETAILS ON DUAL HOUSE CONNECTIONS




FOR CONTINUATION REFER SHEET 7

FOR CONTINUATION REFER SHEET 4

COORDINATE DATUM NOTE:
 HORIZONTAL COORDINATES (Easting) SUPPLIED ARE MAPPING GRID OF AUSTRALIA (MGA), ZONE 56 BASED ON THE UNIVERSAL TRANSVERSE MERCATOR PROJECTION AND THE GEOCENTRIC DATUM OF AUSTRALIA 2020.

ENGINEER'S CERTIFICATION
 I, _____, hereby certify that the as-constructed details shown on this drawing are a true and accurate record of the construction works, in compliance with the approved drawings and approved design.
 RPEQ (signature) RPEQ No. _____ Date: _____

REGISTERED SURVEYOR'S CERTIFICATION
 I, _____, hereby certify that the vertical and horizontal locations and dimensions shown on this plan are a true and correct record and were located by survey.
 Registered Surveyor (sig.) Reg. Surveyor No. 6176 Date: 07/05/2025

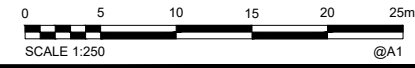

AS CONSTRUCTED

A1	0	07/05/2025	AS CONSTRUCTED DETAILS	RMP	BAS	PASSED		
	INDEX	DATE	REVISIONS	DRAWN	CHECKED	PASSED	INITIALS	DATE

DRAWN	RMP	07/05/2025
CHECKED	BAS	07/05/2025
PASSED		



Unitywater

2018012748517
 2018012748517 - RIDGEVIEW STAGE 12A, 12B, 12C
 AS-CONSTRUCTED SEWER RETICULATION

SHEET 8 OF 8 SHEETS	SCALE 1:250
REVISION DATE	27-06-2024
DISCIPLINE CODE	C
DRAWING NO.	U-2024-5413